

Pike
A 71
5-5-69

MISSISSIPPI
 BOARD OF WATER COMMISSIONERS
 416 North State Street
 Jackson, Mississippi 39201

WATER WELL DRILLERS LOG

5 May 1969 J. T. Carmona, Ken Pike
 date well completed firm name county well located


LANDOWNER:	description of formations encountered	from	to
<u>Johnny Williams</u>	<u>Clay</u>	<u>0</u>	<u>20</u>
(mailing address)	<u>Clay chert</u>	<u>20</u>	<u>110</u>
WELL LOCATION:	<u>Chalk sand</u>	<u>110</u>	<u>80</u>
sec. <u>4</u> T <u>4</u> N R <u>7</u> E	<u>Sand Rock</u>	<u>80</u>	<u>106</u>
<u>3</u> miles <u>N</u> of <u>Samato</u>			
(distance) (direction) (nearest town)			
WELL PURPOSE:			
(home, irrigation, municipal, industrial)			
WELL COMPLETION DATA:			
(1) diameter (inches) <u>4"</u>			
(2) total depth (feet) <u>106</u>			
(3) static water level (feet) <u>80</u> below above top of ground.			
(4) casing <u>Plastic</u> , <u>106</u> (material) (depth)			
<u>4</u> if telescope see back. (size)			
(5) screen <u>4</u> , <u>100</u> (length) (depth to top)			
<u>4</u> , <u>Plastic</u> (size) (material)			
(6) pump <u>1/2</u> , <u>200</u> (HP) (yield gpm)			
<u>Elec</u> (type power)			
(7) electric log (yes or no)			
(organization running log)			
(8) how well bottom plugged <u>wood</u>			
DRILLERS REMARKS:			

JUN 4 1969

MISS. BD. OF WATER COMM.

If well telescopes please sketch and show depths.

GROUND LEVEL

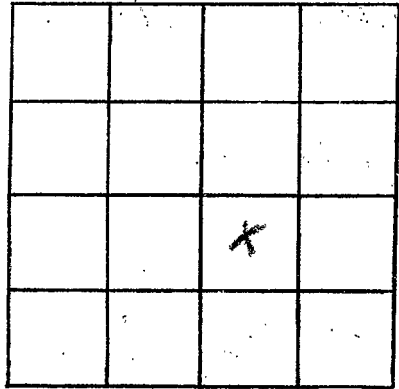

SECTION 4

Please indicate well location X.

ADDITIONAL INFORMATION

If more than one screen,
show locations of each on sketch.