

**MISSISSIPPI
BOARD OF WATER COMMISSIONERS**
416 North State Street
Jackson, Mississippi 39201

CODED

WATER WELL DRILLERS LOG

Pike
A 73
6-69

6-19 19 69 Fitzgerald Well Co Pike
date well completed firm name county well located

LANDOWNER:
Humble Oil Co.
R.R. Summit, Miss.
(mailing address)

description of formations encountered	from	to
<u>Red clay</u>	<u>0</u>	<u>20</u>
<u>Red sand</u>	<u>20</u>	<u>80</u>
<u>Coarse sand & gravel</u>	<u>80</u>	<u>113</u>

WELL LOCATION:
sec. 27 T 4 N R 7 E
IN miles Summit
(distance) (direction) (nearest town)

WELL PURPOSE: Home
(home, irrigation, municipal, industrial)

WELL COMPLETION DATA:

(1) diameter (inches) 4

(2) total depth (feet) 113

(3) static water level (feet) 50 below above top of ground.

(4) casing IRON, 103,
(material) (depth)
4 If telescope see back.
(size)

(5) screen 10, 103
(length) (depth to top)
3, Stainless steel
(size) (material)

(6) pump 1, 15
(HP) (yield gpm)
Uv
(type power)

(7) electric log no
(yes or no)
(organization running log)


(8) how well bottom plugged wood peg

DRILLERS REMARKS:

AUG 4 1969

If well telescopes please sketch and show depths.

GROUND LEVEL

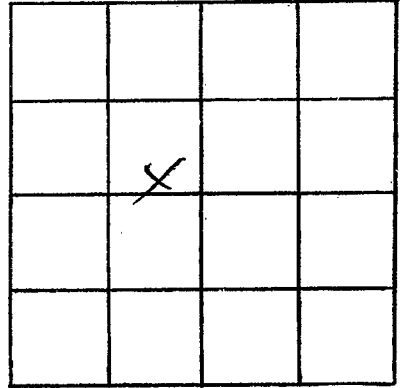

SECTION 27

Please indicate well location X.

ADDITIONAL INFORMATION

If more than one screen,
show locations of each on sketch.