

PIKE
A-74
5-30-69

MISSISSIPPI
 BOARD OF WATER COMMISSIONERS
 416 North State Street
 Jackson, Mississippi 39201



WATER WELL DRILLERS LOG

30 May 1969 J. C. Carver & Son Pike
 date well completed firm name county well located

LANDOWNER:
Mary Gandy
Summit
 (mailing address)

WELL LOCATION:
 sec 23 T 4 N R 7 E
S W


_____ miles _____ of _____
 (distance) (direction) (nearest town)

description of formations encountered	depth	
	from	to
<u>clay</u>	<u>0</u>	<u>10</u>
<u>Red sand clay</u>	<u>10</u>	<u>45</u>
<u>Sand</u>	<u>45</u>	<u>65</u>
<u>Sand shale</u>	<u>65</u>	<u>87</u>

WELL PURPOSE:
 (home, irrigation, municipal, industrial)

WELL COMPLETION DATA:

(1) diameter (inches) 4"
 (2) total depth (feet) 87
 (3) static water level (feet) 60 below above top of ground.
 (4) casing Plastic 87
 (material) (depth)
4 if telescope see back.
 (size)
 (5) screen 6 81
 (length) (depth to top)
4 Plastic
 (size) (material)
 (6) pump 1/2 500
 (HP) (yield gpm)
Elect
 (type power)
 (7) electric log _____ (yes or no)
 _____ (organization running log)
 (8) how well bottom plugged wood

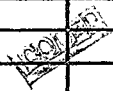


JUN 4 - 1969

MISS. BD. OF WATER COMM.

DRILLERS REMARKS:

If well telescopes please sketch and show depths.

GROUND LEVEL

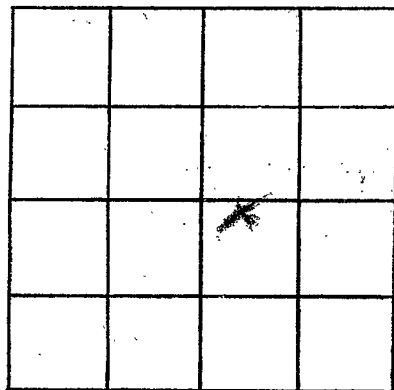

SECTION 23

Please indicate well location X.

ADDITIONAL INFORMATION

If more than one screen,
show locations of each on sketch.