

PIKE

MISSISSIPPI BOARD OF WATER COMMISSIONERS

A75

6-2-64 CODED

WATER WELL DRILLERS LOG

CODED

Date: 6-2, 1964, Driller: Chester Reeves County: PIKE

(Name)

(1) Owner of Land: Lorne Boyd - McComb (Name) (Address)

(2) Location: 1/4, 1/4, Sec. 11 T4R7, 4 miles north of Summit at Pixie Springs (distance) (direction) (Nearest Town)

(3) Topography: (Hilly) (Flat) (Level)

(4) Purpose of Well: Domestic (Domestic Irrigation, Municipal, Industrial, Other)

Description & Color of Materials Sand, Clay, Red Clay, Shell, etc.	Thickness Feet	Depth Feet
Gravel & Sand	5	5
Red yellow loam	25	30
Sand & Gravel	5	35
Blue shale	65	100
Red yellow loam	10	110
Blue shale	265	375
Sand	20	395
Blue shale	10	405
Coarse sand	10	415

Information upon completion of well:

(1) Diameter: 4" - 160 ft. Balance - 1/4 inches

(2) Total Depth: 415 feet

(3) Water Level: 110 feet below top of ground

(4) Cased to: Bottom Size 4x4

(5) Screen: Size 1/4, Length 17'


(6) Were any formations sealed against pollution? yes, no

If YES depth of formation

Why

Drillers Remarks: old well insufficient

CODED

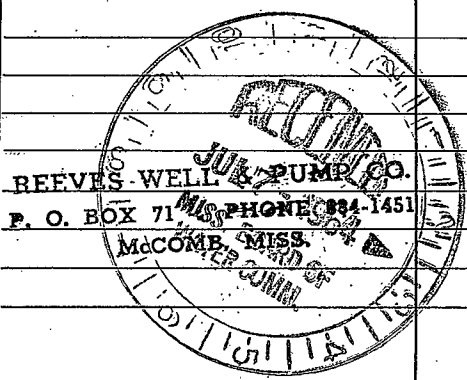

(Use Back Side)

Well No.

THE UNIVERSITY OF CHICAGO  
DIVISION OF THE PHYSICAL SCIENCES  
DEPARTMENT OF CHEMISTRY  
5708 SOUTH CAMPUS DRIVE  
CHICAGO, ILLINOIS 60637