

Pike  
A 76  
8-6-69

MISSISSIPPI  
BOARD OF WATER COMMISSIONERS  
416 North State Street  
Jackson, Mississippi 39201

**CODED**

WATER WELL DRILLERS LOG

8 Aug. 1969 Dr. Cunningham Pike  
date well completed firm name county well located

LANDOWNER:	description of formations encountered	from	to
L. Bayd			
Summit, Miss. (mailing address)	Clay Clay Sand Sand	0 30 50	30 50 84
WELL LOCATION:			
sec 32 T 4 N R 7 E			
4 miles West of Summit (distance) (direction) (nearest town)			
WELL PURPOSE: Home (home, irrigation, municipal, industrial)			
WELL COMPLETION DATA:			
(1) diameter (inches) 4.5			
(2) total depth (feet) 84			
(3) static water level (feet) 60 below top of ground			
(4) casing (material) Plastic (depth) 84			
4" If telescope see back. (size)			
(5) screen 6' length, 78' depth to top			
4" Plastic (size) (material)			
(6) pump 1/2 HP, 9 (yield gpm)			
Electric (type power)			
(7) electric log (yes or no)			
(organization running log)			
(8) how well bottom plugged well			
DRILLERS REMARKS:			


**CODED**

OCT 15 1969

MISS. BD. OF  
WATER COMM.

If well telescopes please sketch and show depths.

GROUND LEVEL

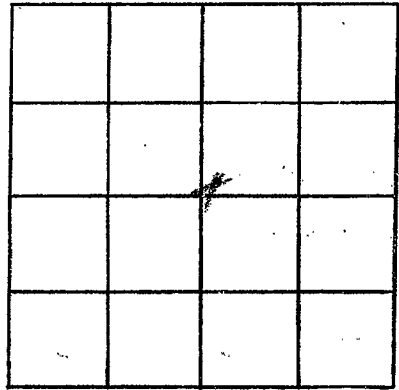

SECTION 37

Please indicate well location X.

ADDITIONAL INFORMATION

If more than one screen, show locations of each on sketch.