

MISSISSIPPI  
BOARD OF WATER COMMISSIONERS  
416 North State Street  
Jackson, Mississippi 39201

WATER WELL DRILLERS LOG

**CODED**

PIKE  
5-1264

PIKE  
A 77  
5-1264

May 12 1969 date well completed  
Kerns Well Drillers firm name  
PIKE county well located

LANDOWNER: Hamel Coleman  
RFD Summit  
(mailing address)

description of formations encountered	from	to
red clay	0	22
red sand	22	86
substrat sand	86	102
sand Rock	102	-
united sand & chalk	102	115
small gravel and coarse sand	115	122

WELL LOCATION:  
sec. 31 T. 4 N. R. 7 E.  
3 1/2 miles W of McCoubert  
(distance) (direction) (nearest town)

WELL PURPOSE: Hamil  
(home, irrigation, municipal, industrial)

- WELL COMPLETION DATA: 11
- (1) diameter (inches) 4"
  - (2) total depth (feet) 122
  - (3) static water level (feet) 77 below top of ground.
  - (4) casing plastic Ballou  
(material) (depth)
  - (size) if telescope see back.
  - (5) screen 6' 116'  
(length) (depth to top)
  - 1/4" plastic  
(size) (material)
  - (6) pump used old  
(type) (yield gpm)
  - gas pump  
(type power)
  - (7) electric log no  
(yes or no)

**CODED**

(organization running log)

(8) how well bottom plugged  
wooden plug


DRILLERS REMARKS:  
old well pumped dry

APR 15 1969

MISS. DEPT. OF  
WATER RESOURCES

If well telescopes please sketch and show depths.

GROUND LEVEL

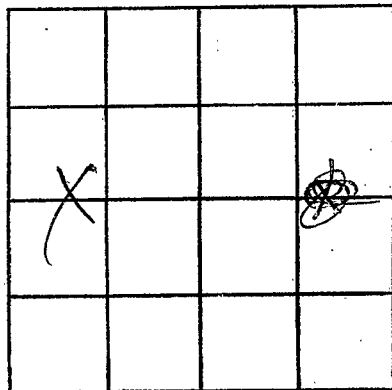

SECTION 31

Please indicate well location X.

ADDITIONAL INFORMATION

If more than one screen,  
show locations of each on sketch.