

MISSISSIPPI  
 BOARD OF WATER COMMISSIONERS  
 416 North State Street  
 Jackson, Mississippi 39201

**CODED**

WATER WELL DRILLERS LOG

PIKE  
 A 78  
 7-8-69

8 July 1969  
 date well completed

J. L. Corbett, Son  
 firm name

Pike  
 county well located

LANDOWNER:	description of formations encountered	from	to
Burton Thornton			
Summit, Miss. (mailing address)	Sand & loam	20	50
	Sand & silt	50	65
	Chalk	65	90
	Sand	90	130

WELL LOCATION:  
 sec. 30 T 4 N R 7 E  
 3 miles West of Summit  
 (distance) (direction) (nearest town)

WELL PURPOSE: Home  
 (home, irrigation, municipal, industrial)

WELL COMPLETION DATA:  
 (1) diameter (inches) 4"  
 (2) total depth (feet) 130  
 (3) static water level (feet) 65 below top of ground  
 (4) casing Plastic 130 (material) (depth)  
 If telescope see back. (size)  
 (5) screen 6' 124 (length) (depth to top)  
 4" Plastic (size) (material)  
 (6) pump 1/2 8 (HP) (yield gpm)  
 Electric (type power)  
 (7) electric log (yes or no)  
 (organization running log)  
 (8) how well bottom plugged Wood


**CODED**

AUG 2 1969

DRILLERS REMARKS:

If well telescopes please sketch and show depths.

GROUND LEVEL

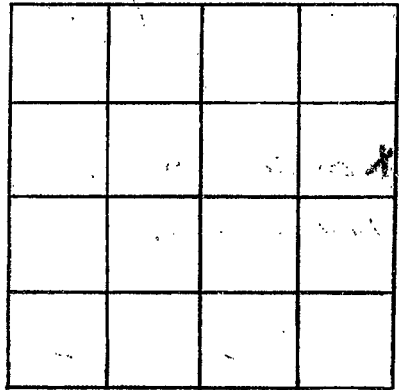

SECTION 2

Please indicate well location X.

ADDITIONAL INFORMATION

A series of horizontal lines for recording additional information, starting below the 'ADDITIONAL INFORMATION' header and extending to the bottom of the page.

If more than one screen, show locations of each on sketch.