

Pike Co
 A 79
 2-13-70

MISSISSIPPI
 BOARD OF WATER COMMISSIONERS
 416 North State Street
 Jackson, Mississippi 39201

CODED

WATER WELL DRILLERS LOG

13 Feb 1970 date well completed
 J. J. Carney, Jr. firm name
 P. R. P. county well located

LANDOWNER:
 L. C. Bass
 James T. Miss. (mailing address)

WELL LOCATION:
 sec. 32 T. 4 N. S. R. 7 E. W.
 4 miles west of McComb (distance) (direction) (nearest town)

WELL PURPOSE: Home (home, irrigation, municipal, industrial)

- WELL COMPLETION DATA:
- (1) diameter (inches) 4
 - (2) total depth (feet) 98
 - (3) static water level (feet) 70 below top of ground
 - (4) casing PL (material), 98 (depth)
 4" (size) if telescope see back.
 - (5) screen 6 (length), 92 (depth to top)
 4 (size), PL (material)
 - (6) pump 5 (HP), 10 (yield gpm)
 Electric (type power)
 - (7) electric log (yes or no)
 (organization running log)
 - (8) how well bottom plugged used

description of formations encountered	from	to
Clay	0	25
Red sand clay	25	65
Sand	65	65
Sand Shale	65	98

CODED


MAR 19 1970

DRILLERS REMARKS:

MISS. BD. OF WATER

If well telescopes please sketch and show depths.

GROUND LEVEL

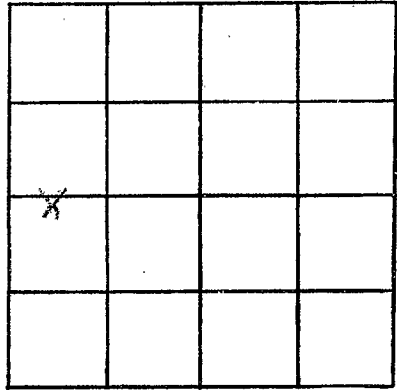

SECTION 32

Please indicate well location X.

ADDITIONAL INFORMATION

Multiple horizontal lines for writing additional information.

If more than one screen, show locations of each on sketch.