

Pike Co  
A80  
2-21-70

MISSISSIPPI  
BOARD OF WATER COMMISSIONERS  
416 North State Street  
Jackson, Mississippi 39201

**CODED**

WATER WELL DRILLERS LOG

21 Feb. 1970 AT. Construction Pike  
date well completed firm name county well located

LANDOWNER:  
O.P. Stripes Jr.  
(mailing address)

WELL LOCATION:  
sec. 20 T 4 N R 7 E  
3/4 miles West of Summit  
(distance) (direction) (nearest town)

WELL PURPOSE: Home  
(home, irrigation, municipal, industrial)

- WELL COMPLETION DATA:
- (1) diameter (inches) 4"
  - (2) total depth (feet) 145 ft.
  - (3) static water level (feet) 20 below top of ground.
  - (4) casing RLC 145  
(material) (depth)  
4 if telescope see back.  
(size)
  - (5) screen 6 139  
(length) (depth to top)  
4 RLC  
(size) (material)
  - (6) pump 5 10  
(HP) (yield gpm)  
Electric  
(type power)
  - (7) electric log \_\_\_\_\_  
(yes or no)  
  
(organization running log)
  - (8) how well bottom plugged wood

description of formations encountered	from	to
<u>clay</u>	<u>0</u>	<u>20</u>
<u>clay shale</u>	<u>20</u>	<u>35</u>
<u>sandstone</u>	<u>35</u>	<u>60</u>
<u>sand</u>	<u>60</u>	<u>90</u>
<u>hard shale</u>	<u>90</u>	<u>130</u>
<u>30'</u>	<u>130</u>	<u>145</u>

**CODED**


MAR 19 1970

MISS. BD. OF  
WATER COMMISSIONERS

DRILLERS REMARKS:

If well telescopes please sketch and show depths.

GROUND LEVEL

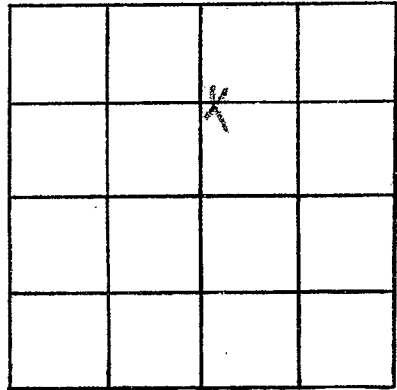

SECTION 26

Please indicate well location X.

ADDITIONAL INFORMATION

If more than one screen,  
show locations of each on sketch.