

Pike Co  
A 81  
3-12-70

MISSISSIPPI  
BOARD OF WATER COMMISSIONERS  
416 North State Street  
Jackson, Mississippi 39201

CODED

WATER WELL DRILLERS LOG

3-12 1970  
date well completed

Fitzgerald  
firm name

Pike  
county well located

LANDOWNER:

Ollie Lee Leggett  
R.R. Summitt Miss.  
(mailing address)

description of formations encountered

from

to

Red clay 0 15  
Red sand 15 60  
Coarse sand & gravel 60 82

WELL LOCATION:

sec. 36 T 4 S R 7 E  
1 miles SSW of Summitt  
(distance) (direction) (nearest town)

WELL PURPOSE: Home  
(home, irrigation, municipal, industrial)

WELL COMPLETION DATA:

- (1) diameter (inches) 4
- (2) total depth (feet) 82
- (3) static water level (feet) 60 below top of ground
- (4) casing (material) plastic, 74 (depth)  
4 (size) if telescope see back.
- (5) screen 8 74 (length) (depth to top)  
4 (size) plastic (material)
- (6) pump 1/2 15 (HP) (yield gpm)  
gas (type power)
- (7) electric log no (yes or no)

CODED

MAR 16 1970

MISS. Bd. OF WATER COMM.

MAR 16 1970


MISS. Bd. OF WATER COMM.

(organization running log)  
(8) how well bottom plugged Woodpecker

DRILLERS REMARKS:

If well telescopes please sketch and show depths.

GROUND LEVEL

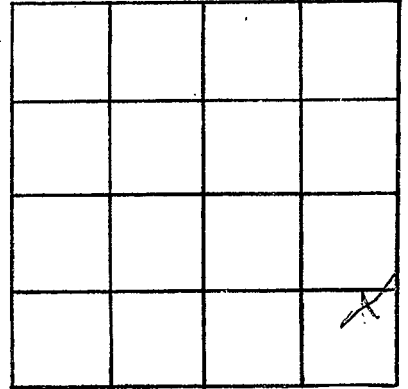

SECTION 36

Please indicate well location X.

ADDITIONAL INFORMATION

If more than one screen,  
show locations of each on sketch.