

PIKE
A 83
7-16-70

MISSISSIPPI
BOARD OF WATER COMMISSIONERS
416 North State Street
Jackson, Mississippi 39201

CODED

WATER WELL DRILLERS LOG

July 16 1970 J.T. Covington + Son PIKE
date well completed firm name county well located

LANDOWNER: J. A. Freeman	description of formations encountered	from	to
(mailing address)			
	Clay	0	30
	Chalk	30	60
	Sand + Gravel	60	90

WELL LOCATION:
sec. 4 T 4 N R 7 E
3 miles North of Summit
(distance) (direction) (nearest town)

WELL PURPOSE: HOME
(home, irrigation, municipal, industrial)


- WELL COMPLETION DATA:
- (1) diameter (inches) 4
 - (2) total depth (feet) 90
 - (3) static water level (feet) 60 below top of ground.
 - (4) casing pl 84 (material) (depth)
 - (size) if telescope see back.
 - (5) screen 6 84 (length) (depth to top)
 - (size) (material)
 - (6) pump 1/2 8 (HP) (yield gpm)
 - Elect (type power)
 - (7) electric log (yes or no)
 - (organization running log)
 - (8) how well bottom plugged wood.

CODED

DRILLERS REMARKS: SEP 10 1970
MISS. BD. OF WATER COMM.

If well telescopes please sketch and show depths.

GROUND LEVEL

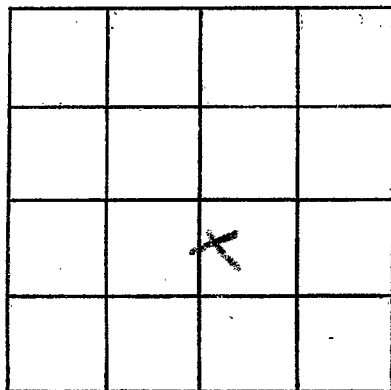

SECTION 4

Please indicate well location X.

ADDITIONAL INFORMATION

If more than one screen, show locations of each on sketch.