

PIKE  
A84  
7-21-70

MISSISSIPPI  
BOARD OF WATER COMMISSIONERS  
416 North State Street  
Jackson, Mississippi 39201

**CODED**

WATER WELL DRILLERS LOG

21 July 1970 J.T. Covington & Son PIKE  
date well completed firm name county well located

LANDOWNER: Alfred Johnson

description of formations encountered	from	to
Clay	0	20
Chalk	20	50
Chalk + Gravel	50	80
Chalk	80	100
Sand + Gravel	100	130

(mailing address)

WELL LOCATION:  
sec. 3 T 4 N R 7 E  
3 miles North of Summit  
(distance) (direction) (nearest town)

WELL PURPOSE: Home  
(home, irrigation, municipal, industrial)

WELL COMPLETION DATA:

- (1) diameter (inches) 4
- (2) total depth (feet) 130
- (3) static water level (feet) 100 below top of ground.
- (4) casing 4 (material), 124 (depth)
- (size) If telescope see back.
- (5) screen 6 (length), 124 (depth to top)
- (size) (material)
- (6) pump 1/2 (HP), 12 (yield gpm)
- Elect. (type power)
- (7) electric log (yes or no)
- (organization running log)
- (8) how well bottom plugged wood


**CODED**

DRILLERS REMARKS:

SEP 10 1970

If well telescopes please sketch and show depths.

GROUND LEVEL

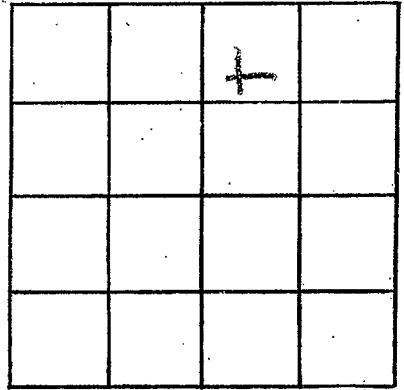

SECTION 3

Please indicate well location X.

ADDITIONAL INFORMATION

A series of horizontal lines for writing additional information.

If more than one screen, show locations of each on sketch.