

Pike
A 87
5-5-70

MISSISSIPPI
BOARD OF WATER COMMISSIONERS
416 North State Street
Jackson, Mississippi 39201

CODED

WATER WELL DRILLERS LOG

May 5 1970 Chester Keene Pike
date well completed firm name county well located

LANDOWNER: Mrs. George Edwards
RFD, Summit
(mailing address)

description of formations encountered	from	to
	<u>red clay</u>	<u>0</u>
<u>red sand</u>	<u>20</u>	<u>85</u>
<u>sand & gravel</u>	<u>85</u>	<u>94</u>

WELL LOCATION:
sec 31 T 4 N R 7 E
4 miles W of McComb
(distance) (direction) (nearest town)

WELL PURPOSE: Home
(home, irrigation, municipal, industrial)

- WELL COMPLETION DATA:
- (1) diameter (inches) 4"
 - (2) total depth (feet) 94
 - (3) static water level (feet) 78 below top of ground.
 - (4) casing Plastic (material) Bottom (depth)
 - (size) if telescope see back.
 - (5) screen 6' (length) 88' (depth to top)
 - 4" (size) Plastic (material)
 - (6) pump old (HP) tenant (yield gpm)
 - (type power)
 - (7) electric log NO (yes or no)
 - (organization running log)

CODED

(8) how well bottom plugged wooden plug


DRILLER'S REMARKS: old 2" well had

MAY 24 1970
JUL 21 1970

MISS. Bd. of
WATER COMMISSIONERS

If well telescopes please sketch and show depths.

GROUND LEVEL

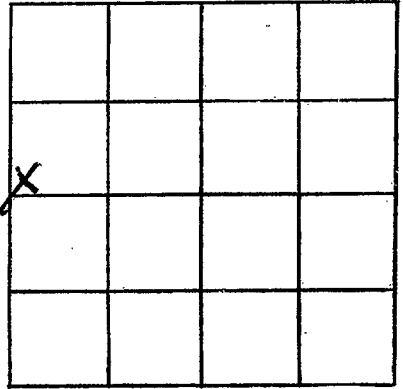

SECTION ~~23~~ 31

Please indicate well location X.

ADDITIONAL INFORMATION

If more than one screen, show locations of each on sketch.