

Pike
A 88
6-25-70

MISSISSIPPI
BOARD OF WATER COMMISSIONERS
416 North State Street
Jackson, Mississippi 39201

CODED

WATER WELL DRILLERS LOG

6-25 date well completed 1970 firm name Fitzgerald Well Serv county well located Pike

LANDOWNER:
Holden Miller
RR. Summit Miss.
(mailing address)

description of formations encountered	from	to
<u>Red clay</u>	<u>0</u>	<u>20</u>
<u>Red sand</u>	<u>20</u>	<u>30</u>
<u>Coarse sand gravel</u>	<u>80</u>	<u>114</u>

WELL LOCATION:
sec. 28 T 4 N R 7 E
2 miles W of Summit
(distance) (direction) (nearest town)

WELL PURPOSE: Home
(home, irrigation, municipal, industrial)

- WELL COMPLETION DATA:
- (1) diameter (inches) 4
 - (2) total depth (feet) 114
 - (3) static water level (feet) 70 below top of ground.
 - (4) casing plastic, 168 (material) (depth)
4 if telescope see back. (size)
 - (5) screen 6, 108 (length) (depth to top)
4 (size) plastic (material)
 - (6) pump 1/2, 10 (HP) (yield gpm)
el (type power)
 - (7) electric log yes (yes or no)
(organization running log)
 - (8) how well bottom plugged ready

CODED


DRILLERS REMARKS:

JUL 24 1970

MISS. BOARD OF WATER COMMISSIONERS

If well telescopes please sketch and show depths.

GROUND LEVEL

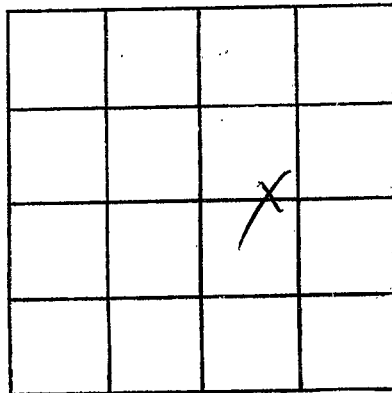

SECTION 28

Please indicate well location X.

ADDITIONAL INFORMATION

If more than one screen, show locations of each on sketch.