

Pike
A 89
6-5-70

MISSISSIPPI
BOARD OF WATER COMMISSIONERS
416 North State Street
Jackson, Mississippi 39201

CODED

WATER WELL DRILLERS LOG

9.5 June 1970 J.T. Conington P. Kl
date well completed firm name county well located

LANDOWNER:
Weidert Hart
Summit
(mailing address)

description of formations encountered	from	to
Clay	0	20
Clay shale	20	25
Sand with shell	25	65
Sand shale	65	75
Sand shale	75	93

WELL LOCATION:
sec 27 T 4 N R 7 E
2 miles west of Summit
(distance) (direction) (nearest town)

WELL PURPOSE: Home
(home, irrigation, municipal, industrial)

WELL COMPLETION DATA:

(1) diameter (inches) 4

(2) total depth (feet) 93

(3) static water level (feet) 70 below top of ground

(4) casing PL 74 (material) (depth)
(size) if telescope see back.

(5) screen 6 74 (length) (depth to top)
4 PL (size) (material)

(6) pump 1/2 10 (HP) (yield gpm)
Electric (type power)

(7) electric log (yes or no)

(organization running log)

(8) how well bottom plugged Wood

CODED


AUG 7 1970

DRILLERS REMARKS:

MISSISSIPPI
BOARD OF WATER COMMISSIONERS
416 NORTH STATE STREET
JACKSON, MISSISSIPPI 39201

If well telescopes please sketch and show depths.

GROUND LEVEL

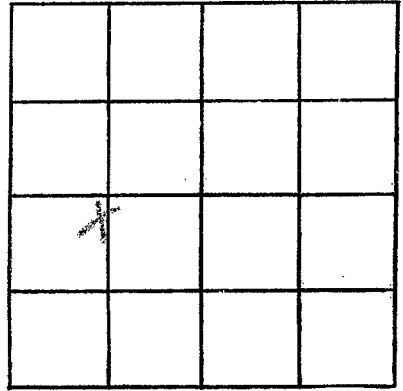

SECTION A

Please indicate well location X.

ADDITIONAL INFORMATION

Lined area for additional information.

If more than one screen, show locations of each on sketch.