

PIKE  
A91  
9-22-70

MISSISSIPPI  
BOARD OF WATER COMMISSIONERS  
416 North State Street  
Jackson, Mississippi 39201

**CODED**

WATER WELL DRILLERS LOG

Sept 20 1970 Chesters Keener Pike  
date well completed firm name county well located

LANDOWNER: Ernest L. Sewers  
RFD 2 Summit  
(mailing address)

description of formations encountered	from	to
clay	0	12
red cherty	12	32
red sand	32	84
red cherty sand	84	89
gray sand	89	100

WELL LOCATION:  
sec 34 T 4 N R 7 E  
1 miles SW of Summit  
(distance) (direction) (nearest town)

WELL PURPOSE: Home  
(home, irrigation, municipal, industrial)

WELL COMPLETION DATA:

- (1) diameter (inches) 4"
- (2) total depth (feet) 100
- (3) static water level (feet) 25 below top of ground.
- (4) casing Plastic bottom  
(material) (depth)
- (5) screen 6' 94  
(length) (depth to top)  
4" Plastic  
(size) (material)
- (6) pump 1/2 Sub 12  
(HP) (yield gpm)  
steel  
(type power)
- (7) electric log No  
(yes or no)
- (organization running log)

**CODED**


(8) how well bottom plugged  
wooden plug

DRILLERS REMARKS:

NOV 16 1970

If well telescopes please sketch and show depths.

GROUND LEVEL

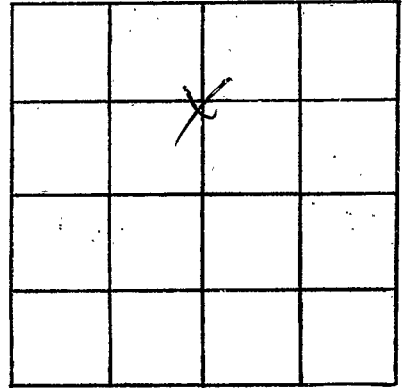

SECTION 34

Please indicate well location X.

ADDITIONAL INFORMATION

If more than one screen, show locations of each on sketch.