

PIKE
A 92
10-23-70

MISSISSIPPI
BOARD OF WATER COMMISSIONERS
416 North State Street
Jackson, Mississippi 39201

CODED

WATER WELL DRILLERS LOG

Oct 23 1970 Chert Keene Pike
date well completed firm name county well located

LANDOWNER Jim Weaver for
McLamb

description of formations encountered	from	to
clay	0	5
Sand & gravel	5	39
Sand & shell	39	40
Sand & shell	40	85
Sand & gravel	85	98

(mailing address)

WELL LOCATION:

sec. 2 T. 4 N. R. 7 E.
4 miles N of Summit
(distance) (direction) (nearest town)

WELL PURPOSE: Pond
(home, irrigation, municipal, industrial)

WELL COMPLETION DATA:

- (1) diameter (inches) 4"
- (2) total depth (feet) 98
- (3) static water level (feet) 53 below top of ground.
- (4) casing Plastic Ballam
(material) (depth)
- (size) if telescope see back.
- (5) screen 10 88
(length) (depth to top)
- 4" Plastic
(size) (material)
- (6) pump 1 Sub 30
(HP) (yield gpm)
- Elect
(type power)
- (7) electric log No
(yes or no)

CODED

(organization running log)

(8) how well bottom plugged
wooden plug


DRILLERS REMARKS:

this well would
carry yield
75 gal/min

NOV 16 1970

If well telescopes please sketch and show depths.

GROUND LEVEL

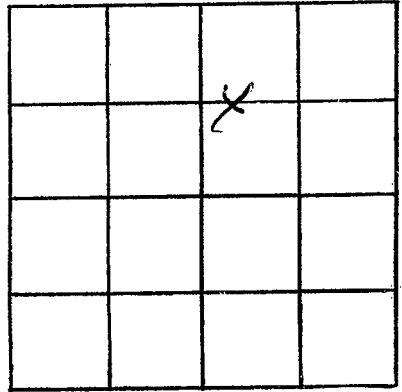

SECTION 2

Please indicate well location X.

ADDITIONAL INFORMATION

If more than one screen,
show locations of each on sketch.