

PIKE
A94
9-3-70

MISSISSIPPI
BOARD OF WATER COMMISSIONERS
416 North State Street
Jackson, Mississippi 39201

CODED

WATER WELL DRILLERS LOG

Sept 3 1970 date well completed
Bates Construction Co. firm name
Pike county well located

LANDOWNER:
Kelly Anderson
McComb, Miss.
(mailing address)

description of formations encountered	from	to
Clay	0	20
Sand	30	40
Chalk	40	60
Sand + Gravel	60	95

WELL LOCATION:
sec. 36 T. 4 N. R. 9 E.
2 miles South of Summit
(distance) (direction) (nearest town)

WELL PURPOSE: Arms
(home, irrigation, municipal, industrial)

- WELL COMPLETION DATA:
- (1) diameter (inches) 4
 - (2) total depth (feet) 95
 - (3) static water level (feet) 60 below above top of ground.
 - (4) casing pl 94
(material) (depth)
(size) if telescope see back.
 - (5) screen 6 94
(length) (depth to top)
pl (size) (material)
 - (6) pump 1/2 12
(HP) (yield gpm)
elect (type power)
 - (7) electric log no
(yes or no)
(organization running log)
 - (8) how well bottom plugged wood

CODED


DEC 11 1970

DRILLERS REMARKS:

MISS. BD. OF
WATER COMMISSIONERS

If well telescopes please sketch and show depths.

GROUND LEVEL

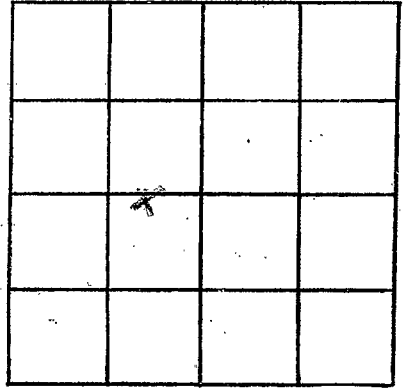

SECTION 3

Please indicate well location X.

ADDITIONAL INFORMATION

If more than one screen, show locations of each on sketch.