

PIKE
A95
9-18-70

MISSISSIPPI
BOARD OF WATER COMMISSIONERS
416 North State Street
Jackson, Mississippi 39201

CODED

WATER WELL DRILLERS LOG

Sept 18 1970 J.T. Covington & Son Pike
date well completed firm name county well located

LANDOWNER:	description of formations encountered	from	to
(mailing address)			
Ray Smith	clay	0	20
Summit, Miss	Chalk	20	40
	SAND	40	80
	SAND + Rock	80	90
	Chalk	90	165
	SAND	165	185
WELL LOCATION:			
sec. 24 T 4 N R 7 E			
2 miles north of Summit			
(distance) (direction) (nearest town)			
WELL PURPOSE: Home			
(home, irrigation, municipal, industrial)			
WELL COMPLETION DATA:			
(1) diameter (inches) 4"			
(2) total depth (feet) 185			
(3) static water level (feet) 90 below top of ground.			
(4) casing (material) PL (depth) 179			
(size) if telescope see back.			
(5) screen (length) 6' (depth to top) 179			
(size) 4" (material) PL			
(6) pump (HP) 1/2 (yield gpm) 12			
(type power) Elect			
(7) electric log (yes or no) no			
(organization running log)			
(8) how well bottom plugged Wood			
DRILLERS REMARKS:			


CODED

DEC 11 1970

MISS. Bd. of WATER COMMISSIONERS

If well telescopes please sketch and show depths.

GROUND LEVEL

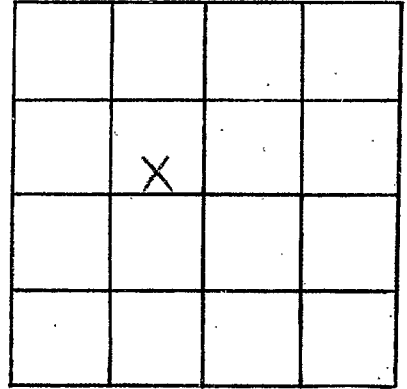

SECTION 24

Please indicate well location X.

ADDITIONAL INFORMATION

If more than one screen, show locations of each on sketch.