

PIKE
A98
12-18-70

MISSISSIPPI
BOARD OF WATER COMMISSIONERS
416 North State Street
Jackson, Mississippi 39201

CODED

WATER WELL DRILLERS LOG

12/18/70 date well completed 1970 firm name Pike county well located

LANDOWNER:
Randy Mack
Summit
(mailing address)

description of formations encountered	from	to
clay	0	10
red sand	10	20
sand	20	50

WELL LOCATION:
sec. 11 T4 N R7 E
5 miles North of Summit
(distance) (direction) (nearest town)

WELL PURPOSE:
(home, irrigation, municipal, industrial)

- WELL COMPLETION DATA:
- (1) diameter (inches) 4
 - (2) total depth (feet) 60
 - (3) static water level (feet) 20 below top of ground.
 - (4) casing PI, 44 (material) (depth)
(size) If telescope see back.
 - (5) screen 6, 44 (length) (depth to top)
4, PI (size) (material)
 - (6) pump 4 (HP) 10 (yield gpm)
plastic (type power)
 - (7) electric log (yes or no)
 - (organization running log)
 - (8) how well bottom plugged wood

CODED


JAN 19 1971

MISS. BD. OF
WATER COMMISSIONERS

DRILLERS REMARKS:

If well telescopes please sketch and show depths.

GROUND LEVEL

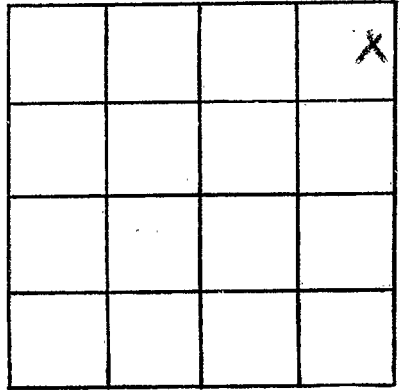

SECTION 11

Please indicate well location X.

ADDITIONAL INFORMATION

If more than one screen,
show locations of each on sketch.