

Dicho  
A 99  
8-18-69

MISSISSIPPI  
 BOARD OF WATER COMMISSIONER  
 416 North State Street  
 Jackson, Mississippi 39201

**CODED**

**WATER WELL DRILLERS LOG**

18 Aug date well completed      A. T. Covington firm name      Rift county well located

LANDOWNER: W.T. Jackson  
Summit, Miss.  
 (mailing address)

description of formations encountered	from	to
<u>Clay</u>	<u>0</u>	<u>20</u>
<u>Soft sand</u>	<u>20</u>	<u>30</u>
<u>Sand Gravel</u>	<u>30</u>	<u>66</u>
<u>sand</u>	<u>40</u>	<u>67</u>

WELL LOCATION:  
 sec. 17 T 4 N R. 7 E  
5 miles West of Summit  
 (distance) (direction) (nearest town)

WELL PURPOSE: Home  
 (home, irrigation, municipal, industrial)

- WELL COMPLETION DATA:
- (1) diameter (inches) 4
  - (2) total depth (feet) 67
  - (3) static water level (feet) 40 ~~above~~ below top of ground.
  - (4) casing Pl, 67  
 (material) (depth)  
4" If telescope see back.  
 (size)
  - (5) screen 6, 61  
 (length) (depth to top)  
4, Pl  
 (size) (material)
  - (6) pump 1/2, 9  
 (HP) (yield gpm)  
Electric  
 (type power)
  - (7) electric log                       
 (yes or no)  
    
 (organization running log)
  - (8) how well bottom plugged wood

**CODED**

OCT 15 1969

MISS. BD. OF  
 WATER COMM.

DRILLERS REMARKS:

---




---



---

If well telescopes please sketch and show depths.

GROUND LEVEL

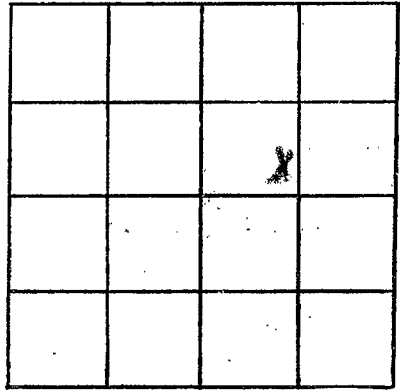

SECTION 19

Please indicate well location X.

ADDITIONAL INFORMATION

If more than one screen,  
show locations of each on sketch.