

PIRE
A101
2-70

MISSISSIPPI
BOARD OF WATER COMMISSIONERS
416 North State Street
Jackson, Mississippi 39201

CODED

WATER WELL DRILLERS LOG

2 1970 J.T. Covington Son PIRE
date well completed firm name county well located

LANDOWNER:
Carl Wilkerson
Summit, Miss.
(mailing address)

description of formations encountered	from	to
clay	0	25
shale	25	35
good shale	35	45
hard	45	72

WELL LOCATION:
sec 17 T 24 N R 7 E
4 miles West of Summit
(distance) (direction) (nearest town)

WELL PURPOSE:
(home, irrigation, municipal, industrial)

- WELL COMPLETION DATA:
- (1) diameter (inches) 4
 - (2) total depth (feet) 72
 - (3) static water level (feet) 60 below top of ground.
 - (4) casing Pl. 72 (material) (depth)
 - (size) if telescope see back.
 - (5) screen 6 66 (length) (depth to top)
 - 4 Pl. (size) (material)
 - (6) pump 1/2 8 (HP) (yield gpm)
 - Electric (type power)
 - (7) electric log (yes or no)
 - (organization running log)
 - (8) how well bottom plugged wood

CODED


FEB 16 1970

MISS. BD. OF
WATER COM.

DRILLERS REMARKS:

If well telescopes please sketch and show depths.

GROUND LEVEL

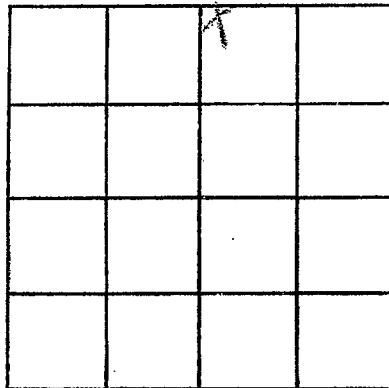

SECTION 17

Please indicate well location X.

ADDITIONAL INFORMATION

If more than one screen, show locations of each on sketch.