

PIKE
A103
2-17-71

MISSISSIPPI
BOARD OF WATER COMMISSIONERS
416 North State Street
Jackson, Mississippi 39201

CODED

FEB 19 1971

MISS. BD. OF
WATER COMMISSIONERS

WATER WELL DRILLERS LOG

Pike


Feb-17-71 date well completed 1971
Chester Kelner firm name
Pike county well located

LANDOWNER	description of formations encountered	from	to
Jack M. Kelly Summit - (mailing address)	clay chalk	0 15 15 20	
WELL LOCATION: sec. 23 T 4 N R 7 E 1/2 miles N of Summit (distance) (direction) (nearest town)	Sand & gravel chalk	20 55 55 70	
WELL PURPOSE: (home, irrigation, municipal, industrial)	Sand & gravel chalk	70 80 80 90	
WELL COMPLETION DATA: (1) diameter (inches) 4" (2) total depth (feet) 104 (3) static water level (feet) 51 below top of ground. (4) casing Plast Ballon (material) (depth) (5) screen 6' 98' (length) (depth to top) 4" Plast (size) (material) (6) pump 1/2 HP - 12 (HP) (yield gpm) elect. (type power) (7) electric log no (yes or no) (organization running log) (8) how well bottom plugged wood plug	Sand & gravel chalk Sand & gravel	90 104	
DRILLERS REMARKS: new house			

CODED

If well telescopes please sketch and show depths.

GROUND LEVEL

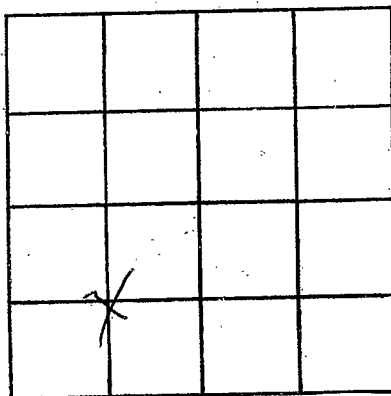

SECTION 23

Please indicate well location X.

ADDITIONAL INFORMATION

If more than one screen,
show locations of each on sketch.