

PIKE
A 104
1-27-71

MISSISSIPPI
BOARD OF WATER COMMISSIONERS
 416 North State Street
 Jackson, Mississippi 39201

CODED

WATER WELL DRILLERS LOG

28 Jan 1971 71988 Waterwell Pike
 date well completed firm name county well located

LANDOWNER:
Coy P. Eason
Summit
 (mailing address)

WELL LOCATION:
 sec 29 T 04 N R 7 E
3 miles West of Summit
 (distance) (direction) (nearest town)

WELL PURPOSE:
 (home, irrigation, municipal, industrial)

- WELL COMPLETION DATA:**
- (1) diameter (inches) 4
 - (2) total depth (feet) 95
 - (3) static water level (feet) 75 below above top of ground.
 - (4) casing pl, 89
 (material) (depth)
 (size) If telescope see back.
 - (5) screen 6, 89
 (length) (depth to top)
4 pl
 (size) (material)
 - (6) pump 1/2, 3
 (HP) (yield gpm)
electric
 (type power)
 - (7) electric log (yes or no)
 - (8) how well bottom plugged wood

description of formations encountered	from	to
<u>clay</u>	<u>0</u>	<u>20</u>
<u>chert</u>	<u>20</u>	<u>25</u>
<u>red soil</u>	<u>25</u>	<u>50</u>
<u>chert</u>	<u>50</u>	<u>60</u>
<u>red</u>	<u>60</u>	<u>95</u>

CODED


FEB 26 1971

MISC. DIV. OF
 WATER CONTROL

DRILLERS REMARKS:

If well telescopes please sketch and show depths.

GROUND LEVEL

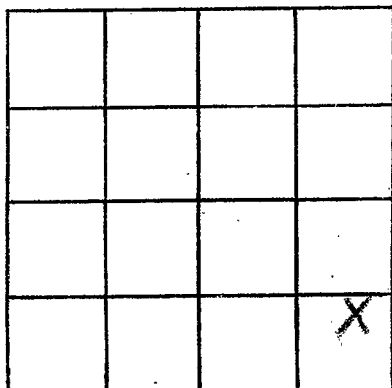

SECTION 19

Please indicate well location X.

ADDITIONAL INFORMATION

If more than one screen, show locations of each on sketch.