

PIKE
A 106
3-19-71

MISSISSIPPI
BOARD OF WATER COMMISSIONERS
416 North State Street
Jackson, Mississippi 39201

CODED

WATER WELL DRILLERS LOG

3-19 1971
date well completed

Frederick Well Co
firm name

Pike
county well located

LANDOWNER:
Henry Wells
R.R. Lunt Mass
(mailing address)

description of formations encountered

from to

| | | |
|-------------------|------------|------------|
| <i>Red clay</i> | <i>0</i> | <i>20</i> |
| <i>Red sand</i> | <i>20</i> | <i>70</i> |
| <i>white clay</i> | <i>70</i> | <i>130</i> |
| <i>fine sand</i> | <i>130</i> | <i>150</i> |
| <i>loose sand</i> | <i>150</i> | <i>160</i> |

WELL LOCATION:

sec. 5 T. 4 N. R. 7 E.
5 miles W of Lunt
(distance) (direction) (nearest town)

WELL PURPOSE:

Home
(home, irrigation, municipal, industrial)

WELL COMPLETION DATA:

- (1) diameter (inches) 4
- (2) total depth (feet) 160
- (3) static water level (feet) 70 below above top of ground.
- (4) casing Black 154
(material) (depth)
4 if telescope see back.
(size)
- (5) screen 6 154
(length) (depth to top)
4 Black
(size) (material)
- (6) pump 1/2 10
(HP) (yield gpm)
elec
(type power)
- (7) electric log no
(yes or no)
(organization running log)
- (8) how well bottom plugged cleanly

CODED


MAR 31 1971

DRILLERS REMARKS:

MISS. Bd. OF
WATER COMM.

If well telescopes please sketch and show depths.

GROUND LEVEL

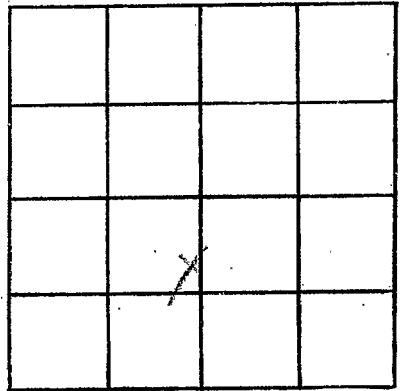

SECTION 5

Please indicate well location X.

ADDITIONAL INFORMATION

If more than one screen, show locations of each on sketch.