

PIKE
A 107
3-12-71

MISSISSIPPI
BOARD OF WATER COMMISSIONERS
416 North State Street
Jackson, Mississippi 39201

CODED

WATER WELL DRILLERS LOG

March 21 1971 *Chester Keener* *Pike*
date well completed firm name county well located

LANDOWNER *Louella Parker*
M.R. Summit
(mailing address)

description of formations encountered	from	to
	<i>clay</i>	<i>0</i>
<i>Red Sand</i>	<i>12</i>	<i>61</i>
<i>Peapack Sand</i>	<i>61</i>	<i>86</i>

WELL LOCATION:
sec. *35* T *4* N R. *7* E
1/2 miles *N* *M.E. Comb*
(distance) (direction) (nearest town)

WELL PURPOSE: *Drain*
(home, irrigation, municipal, industrial)

- WELL COMPLETION DATA:
- (1) diameter (inches) *4 1/2*
 - (2) total depth (feet) *86*
 - (3) static water level (feet) *42* below top of ground. ~~above~~
 - (4) casing *Start Bottom*
(material) (depth)
 - (size) if telescope see back.
 - (5) screen *6'* *40'*
(length) (depth to top)
 - 4"* *plst*
(size) (material)
 - (6) pump *1/2 sub* *12*
(HP) (yield gpm)
 - elect*
(type power)
 - (7) electric log *no*
(yes or no)
 - (organization running log)

CODED


APR 27 1971

(8) how well bottom plugged *wood plug*
DRILLERS REMARKS: *New haul.*

MISS. BD. OF
WATER COMM.

If well telescopes please sketch and show depths.

GROUND LEVEL

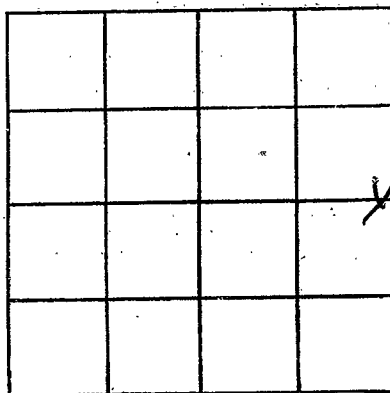

SECTION 35

Please indicate well location X.

ADDITIONAL INFORMATION

If more than one screen, show locations of each on sketch.