

PIKE
A108
3-12-71
March 12, 71

MISSISSIPPI
BOARD OF WATER COMMISSIONERS
416 North State Street
Jackson, Mississippi 39201

CODED

WATER WELL DRILLERS LOG

Pike

date well completed 19 71 firm name Chester Keenes county well located Pike

LANDOWNER: Van East
MR - Summit

description of formations encountered	from	to
Red clay	0	17
Red sand & chalk	17	20
Red chalk	20	30
Gravel & sand	30	42

(mailing address)

WELL LOCATION:
sec 36 T 4 N R 7 E
1/2 miles N of McCamba
(distance) (direction) (nearest town)

WELL PURPOSE: Domestic
(home, irrigation, municipal, industrial)

WELL COMPLETION DATA:

- (1) diameter (inches) 4 1/2"
- (2) total depth (feet) 42'
- (3) static water level (feet) 46' below top of ground. ~~above~~
- (4) casing plastic Bottom
(material) (depth)
- (size) If telescope see back.
- (5) screen 6' 4 1/2'
(length) (depth to top)
- 4" plastic
(size) (material)
- (6) pump 1/2 HP 12
(HP) (yield gpm)
- elect
(type power)
- (7) electric log no
(yes or no)

CODED

(organization running log)

(8) how well bottom plugged wooden plug


DRILLERS REMARKS:
New house.

APR 27 1971

MISS. BD. OF
WATER COMMISSIONERS

If well telescopes please sketch and show depths.

GROUND LEVEL

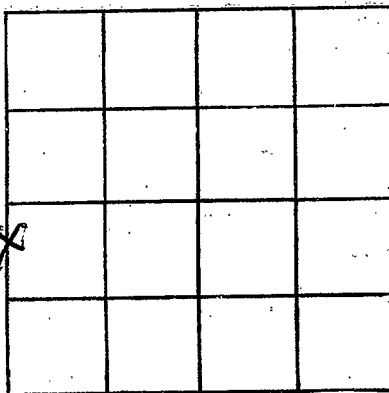

SECTION 36

Please indicate well location X.

ADDITIONAL INFORMATION

If more than one screen,
show locations of each on sketch.