

PIKE
A109
5-4-71

MISSISSIPPI
BOARD OF WATER COMMISSIONERS
416 North State Street
Jackson, Mississippi 39201

CODED

WATER WELL DRILLERS LOG

5-4-71 date well completed
21 firm name
Pike county well located

LANDOWNER:

James L. Stone
R.R. McComb Miss.
(mailing address)

description of formations encountered

from	to
0	20
20	99
99	108

Red clay
Red sand
Coarse sand & gravel

WELL LOCATION:

sec. 29 T. 4 N. R. 2 E
4 miles NW of McComb
(distance) (direction) (nearest town)

WELL PURPOSE:

(home, irrigation, municipal, industrial)

WELL COMPLETION DATA:

- (1) diameter (inches) 4
- (2) total depth (feet) 108
- (3) static water level (feet) 70 below top of ground.
- (4) casing 4" (material) 100 (depth)
4" (size) if telescope see back.
- (5) screen 8" (length) 100 (depth to top)
4" (size) 4" (material)
- (6) pump 1/2 (HP) 12 (yield gpm)
Electric (type power)
- (7) electric log (yes or no)

(organization running log)

- (8) how well bottom plugged (wood)

DRILLERS REMARKS:


CODED

MAY 10 1971

MISSISSIPPI
BOARD OF WATER COMMISSIONERS
OFFICE OF THE SECRETARY

If well telescopes please sketch and show depths.

GROUND LEVEL

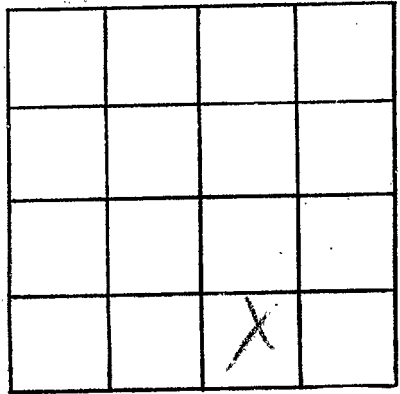

SECTION 29

Please indicate well location X.

ADDITIONAL INFORMATION

If more than one screen,
show locations of each on sketch.