

PIKE  
A 110  
6-7-71

MISSISSIPPI  
BOARD OF WATER COMMISSIONERS  
416 North State Street  
Jackson, Mississippi 39201

**CODED**

WATER WELL DRILLERS LOG

6-7 1971 Ferguson Well Co Pike  
date well completed firm name county well located

LANDOWNER:  
William Ferguson  
R.R. Summit, Miss.  
(mailing address)

description of formations encountered	from	to
<u>Red clay</u>	<u>0</u>	<u>20</u>
<u>Red sand</u>	<u>20</u>	<u>90</u>
<u>Coarse sand &amp; gravel</u>	<u>90</u>	<u>106</u>

WELL LOCATION:  
sec. 14 T. 4 N. R. 7 E  
1/2 miles N of Summit  
(distance) (direction) (nearest town)

WELL PURPOSE:  
Home  
(home, irrigation, municipal, industrial)

WELL COMPLETION DATA:  
(1) diameter (inches) 4  
(2) total depth (feet) 106  
(3) static water level (feet) 50 below above top of ground.  
(4) casing Plastic 98  
(material) (depth)  
4 (size) If telescope see back.  
(5) screen 8 98  
(length) (depth to top)  
4 (size) plastic (material)  
(6) pump 3/4 7  
(HP) (yield 'gpm)  
Electric (type power)  
(7) electric log yes  
(yes or no)  
(organization running log)  
(8) how well bottom plugged usually

**CODED**


JUN 14 1971

DRILLERS REMARKS:

MISS. BD. OF  
WATER COMM.

If well telescopes please sketch and show depths.

GROUND LEVEL

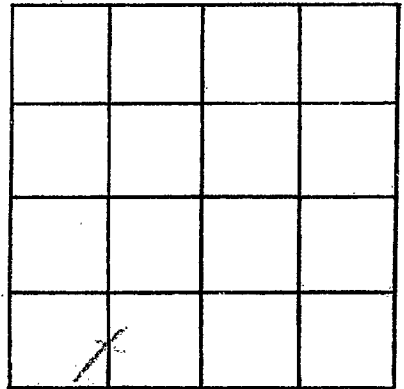

SECTION 11

Please indicate well location X.

ADDITIONAL INFORMATION

If more than one screen, show locations of each on sketch.