

Pike
A-112
7-29-71

MISSISSIPPI
BOARD OF WATER COMMISSIONERS
416 North State Street
Jackson, Mississippi 39201

CODED

WATER WELL DRILLERS LOG

7-29 1971
date well completed

Hydrosystems
firm name

Pike
county well located

LANDOWNER:
Douglas Jewell
R.L. Sumitris
(mailing address)

description of formations encountered	from	to
<i>Red Clay</i>	<i>0</i>	<i>20</i>
<i>Red Sand</i>	<i>20</i>	<i>30</i>
<i>white chalk</i>	<i>30</i>	<i>90</i>
<i>Coarse Sand</i>	<i>90</i>	<i>121</i>

WELL LOCATION:
sec. *12* T. *4* (N) S R. *2* (E) W
5 miles *N* of *Sumit*
(distance) (direction) (nearest town)

WELL PURPOSE:
Home
(home, irrigation, municipal, industrial)

- WELL COMPLETION DATA:
- (1) diameter (inches) 4
 - (2) total depth (feet) 121
 - (3) static water level (feet) 75 below above top of ground.
 - (4) casing *white* (material), *113* (depth),
4 (size) if telescope see back.
 - (5) screen *8* (length), *113* (depth to top),
4 (size), *plastic* (material)
 - (6) pump *1/2* (HP), *8* (yield gpm),
elc (type power)
 - (7) electric log *no* (yes or no)
(organization running log)
 - (8) how well bottom plugged *woolny*

CODED


AUG 11 1971

DRILLERS REMARKS:

MISS. BD. OF
WATER COMMISSIONERS

If well telescopes please sketch and show depths.

GROUND LEVEL

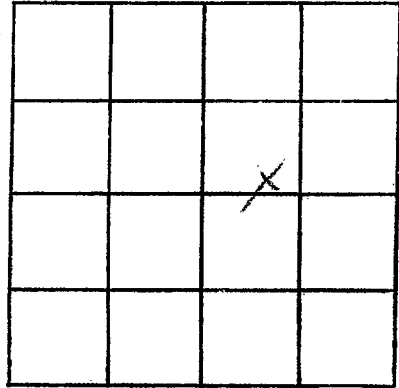

SECTION 12

Please indicate well location X.

ADDITIONAL INFORMATION

If more than one screen,
show locations of each on sketch.