

MISSISSIPPI  
BOARD OF WATER COMMISSIONERS  
416 North State Street  
Jackson, Mississippi 39201

**CODED**

WATER WELL DRILLERS LOG

Pike  
A-113  
7-9-71

9/24/71 1971 S.P. Waterwell Pike  
date well completed firm name county well located

LANDOWNER:	description of formations encountered	from	to
Lot A Ford McComb (mailing address)			
WELL LOCATION: sec. 12 T 40 N R 7 E 5 miles N of Summit (distance) (direction) (nearest town)			
WELL PURPOSE: (home, irrigation, municipal, industrial)			
WELL COMPLETION DATA: (1) diameter (inches) 4 (2) total depth (feet) 125 (3) static water level (feet) 40 below top of ground. (4) casing (material) Pl. (depth) 19 (size) if telescope see back. (5) screen (length) 6 (depth to top) 119 (size) 4 (material) Pl. (6) pump (HP) 1 (yield gpm) 12 (type power) electric (7) electric log (yes or no) (organization running log) (8) how well bottom plugged wood			
DRILLERS REMARKS:			


**CODED**

SEP 10 1971

MISS. BD. OF  
WATER COMMISSIONERS

If well telescopes please sketch and show depths.

GROUND LEVEL

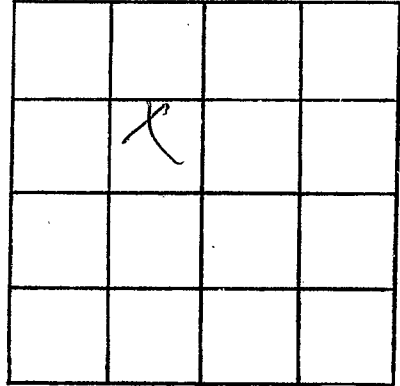

SECTION 12

Please indicate well location X.

ADDITIONAL INFORMATION

If more than one screen,  
show locations of each on sketch.