

Pike  
A-114  
7-20-71

MISSISSIPPI  
BOARD OF WATER COMMISSIONERS  
416 North State Street  
Jackson, Mississippi 39201

WATER WELL DRILLERS LOG

**CODED**

20 July  
date well completed

1971 S&P Water well  
firm name

Pike  
county well located

LANDOWNER:	description of formations encountered	from	to
Howard Givens Summit (mailing address)	Clay Silt Sand	0	20 40 60 75
WELL LOCATION: sec 34 T 4 N R 10 E 2 miles W of Summit (distance) (direction) (nearest town)			
WELL PURPOSE: (home, irrigation, municipal, industrial)			
WELL COMPLETION DATA: (1) diameter (inches) 4 (2) total depth (feet) 95 ft (3) static water level (feet) 65 below top of ground. (4) casing (material) 11 (depth) 89 (size) if telescope see back. (5) screen 6 (length) 89 (depth to top) 4 (size) 11 (material) (6) pump 1/4 (HP) 6 (yield gpm) Elect (type power) (7) electric log (yes or no)			
(8) how well bottom plugged			
DRILLERS REMARKS:			


**CODED**

SEP 10 1971

MISS. DEP. OF  
WATER COMMISSIONERS

If well telescopes please sketch and show depths.

GROUND LEVEL

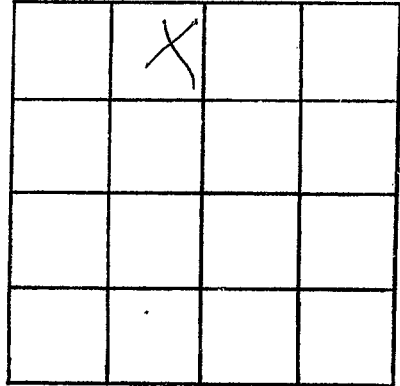

SECTION 34

Please indicate well location X.

ADDITIONAL INFORMATION

If more than one screen, show locations of each on sketch.