

MISSISSIPPI  
 BOARD OF WATER COMMISSIONERS  
 416 North State Street  
 Jackson, Mississippi 39201

WATER WELL DRILLERS LOG

**CODED**

Pike  
 A-116  
 6-28-71

June 28 1971 date well completed  
 Chester Kewer firm name  
 Pike county well located

LANDOWNER: John L. ...  
 Station Baptist Church  
 RD Summit  
 (mailing address)

description of formations encountered	from	to
	Sandy clay	0
Sand & gravel	12	35
Coarse sand	35	70

WELL LOCATION:  
 sec. 4 T 4 N R 7 E  
 at Johnston Station  
 (distance) miles (direction) of (nearest town)

WELL PURPOSE: Church Home  
 (home, irrigation, municipal, industrial)

- WELL COMPLETION DATA:
- (1) diameter (inches) 4"
  - (2) total depth (feet) 70
  - (3) static water level (feet) 30 below top of ground.
  - (4) casing Plast Bottom  
 (material) (depth)
  - (size) if telescope see back.
  - (5) screen 6' 64'  
 (length) (depth to top)
  - 4" Plast  
 (size) (material)
  - (6) pump 1/2 Sub 15 15  
 (HP) (yield gpm)
  - sleeve  
 (type power)
  - (7) electric log NO  
 (yes or no)
  - (organization running log)
  - (8) how well bottom plugged wooden plug

**CODED**


SEP 17 1971

DRILLERS REMARKS:  
 old well had.

MISS. BD. OF  
 WATER COMMISSIONERS

If well telescopes please sketch and show depths.

GROUND LEVEL

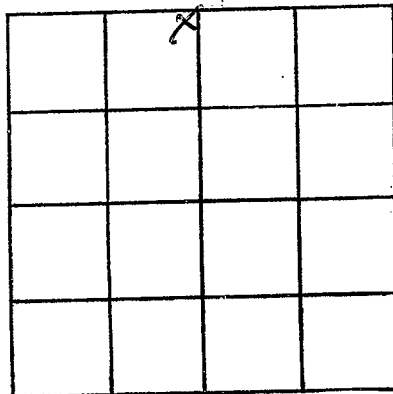

SECTION 1

Please indicate well location X.

ADDITIONAL INFORMATION

If more than one screen, show locations of each on sketch.