

Pike
A118
10-21-71

MISSISSIPPI
BOARD OF WATER COMMISSIONERS
416 North State Street
Jackson, Mississippi 39201

CODED

WATER WELL DRILLERS LOG

10-21 1971 Fitzgerald Pike
date well completed firm name county well located

LANDOWNER:	description of formations encountered	from	to
<u>Bernie Robinson</u>			
<u>R.R. Summit Miss.</u> (mailing address)	<u>Red clay</u>	<u>6</u>	<u>20</u>
	<u>Red sand</u>	<u>20</u>	<u>85</u>
	<u>Coarse sand</u>	<u>85</u>	<u>95</u>

WELL LOCATION:
sec. 36 T 4 N R 7 E
S W
1 miles S of Summit
(distance) (direction) (nearest town)

WELL PURPOSE: Home
(home, irrigation, municipal, industrial)

- WELL COMPLETION DATA:
- (1) diameter (inches) 4
 - (2) total depth (feet) 95
 - (3) static water level (feet) 70 below above top of ground.
 - (4) casing Alu. 89,
(material) (depth)
4 if telescope see back.
(size)
 - (5) screen 6 89
(length) (depth to top)
 - (6) pump 4 plastic
(size) (material)
 - (7) pump 1/2 10
(HP) (yield gpm)
 - alu
(type power)
 - (8) electric log no
(yes or no)
 - (organization running log)
 - (8) how well bottom plugged covered

CODED


OCT 20 1971

DRILLERS REMARKS:

MISS. BD. OF
WATER COMM.

If well telescopes please sketch and show depths.

GROUND LEVEL

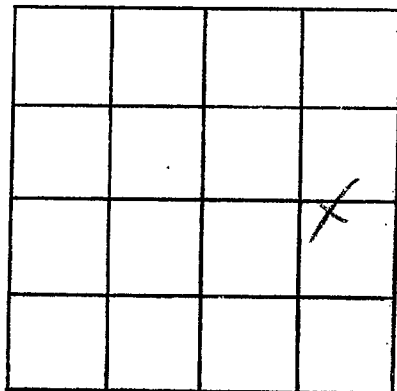

SECTION 36

Please indicate well location X.

ADDITIONAL INFORMATION

If more than one screen,
show locations of each on sketch.