

Pike  
A 119  
11-11-71

MISSISSIPPI  
BOARD OF WATER COMMISSIONERS  
416 North State Street  
Jackson, Mississippi 39201

**CODED**

WATER WELL DRILLERS LOG

11-11 date well completed 1971 firm name *Floyd Well Serv* county well located *Pike*


LANDOWNER:	description of formations encountered	from	to
<i>Hosea Crawley</i> <i>R.R. Summit Miss.</i> (mailing address)			
WELL LOCATION:	<i>Red Sand</i>	<i>20</i>	<i>80</i>
sec. <i>3</i> T. <i>4</i> N. R. <i>7</i> E	<i>Red gravel</i>	<i>80</i>	<i>90</i>
<i>2</i> miles <i>W</i> of <i>Sumit</i>	<i>Red Sand</i>	<i>90</i>	<i>115</i>
(distance) (direction) (nearest town)	<i>Coarse sand &amp; gravel</i>	<i>115</i>	<i>128</i>
WELL PURPOSE: (home, irrigation, municipal, industrial)			
WELL COMPLETION DATA:			
(1) diameter (inches) <i>4</i>			
(2) total depth (feet) <i>128</i>			
(3) static water level (feet) <i>75</i> below above top of ground.			
(4) casing <i>Plastic</i> , <i>120</i> , (material) (depth)			
<i>4</i> (size) if telescope see back.			
(5) screen <i>8</i> , <i>120</i> (length) (depth to top)			
<i>4</i> , <i>Plastic</i> (size) (material)			
(6) pump <i>1/2</i> , <i>10</i> (HP) (yield gpm)			
<i>Wlee</i> (type power)			
(7) electric log <i>No</i> (yes or no)			
(organization running log)			
(8) how well bottom plugged <i>wood plug</i>			
DRILLERS REMARKS:			

NOV 20 1971

MISS. Bd. of  
**CODED**

If well telescopes please sketch and show depths.

GROUND LEVEL

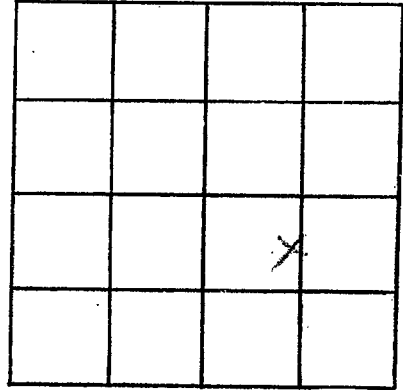

SECTION 2

Please indicate well location X.

ADDITIONAL INFORMATION

If more than one screen,  
show locations of each on sketch.