

Pike
A120
10-22-71

MISSISSIPPI
BOARD OF WATER COMMISSIONERS
416 North State Street
Jackson, Mississippi 39201

DEC 6 1971

WATER WELL DRILLERS LOG

CODED


27 Oct 1971 J-T Construction, Inc. date well completed firm name
Pike county well located

LANDOWNER:	description of formations encountered	from	to
Dennis Brown			
Johnston Station (mailing address)	Clay Clay Sand	0 15 25	15 25 75
WELL LOCATION: sec. <u>1</u> T. <u>4</u> S. R. <u>7</u> E. <u>1</u> miles <u>East</u> of <u>J.S.</u> (distance) (direction) (nearest town)			
WELL PURPOSE: (home, irrigation, municipal, industrial)			
WELL COMPLETION DATA: (1) diameter (inches) <u>4</u> (2) total depth (feet) <u>75</u> (3) static water level (feet) <u>40</u> below/above top of ground. (4) casing <u>PI</u> <u>69</u> (material) (depth) _____ If telescope see back. (size) (5) screen <u>6</u> <u>69</u> (length) (depth to top) <u>4</u> <u>PI</u> (size) (material) (6) pump <u>1/2</u> <u>8</u> (HP) (yield gpm) <u>Elect</u> (type power) (7) electric log _____ (yes or no) _____ (organization running log) (8) how well bottom plugged <u>wood</u>			
DRILLERS REMARKS:			

CODED

If well telescopes please sketch and show depths.

GROUND LEVEL

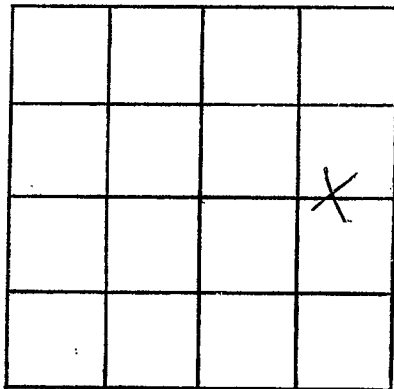

SECTION 1

Please indicate well location X.

ADDITIONAL INFORMATION

A series of horizontal lines for writing additional information, located to the right of the 'ADDITIONAL INFORMATION' header.

If more than one screen, show locations of each on sketch.