

MISSISSIPPI
 BOARD OF WATER COMMISSIONERS
 416 North State Street
 Jackson, Mississippi 39201

WATER WELL DRILLERS LOG

CODED

Pike
 A122
 11-27-71

NOV 27 1971 date well completed
 Chestnut Keens firm name
 Pike county well located

LANDOWNER: David & Carney
 P.O. Summit
 (mailing address)

description of formations encountered	from	to
Clay	0	15
Sand	15	28
Sand & Gravel	48	62

WELL LOCATION:
 sec. 23 T 4 N R 7 E
 1 miles N of Summit
 (distance) (direction) (nearest town)

WELL PURPOSE: Home
 (home, irrigation, municipal, industrial)

WELL COMPLETION DATA:

- (1) diameter (inches) 4
- (2) total depth (feet) 62
- (3) static water level (feet) 21 below top of ground
- (4) casing (material) plastic (depth) bottom
- (5) screen (length) 6' (depth to top) 56'
- (6) pump (HP) 1/2 (yield gpm) 15
- (7) electric log (yes or no) no

CODED


(organization running log)

(8) how well bottom plugged
 wood plug

DRILLERS REMARKS:
 new location

If well telescopes please sketch and show depths.

GROUND LEVEL

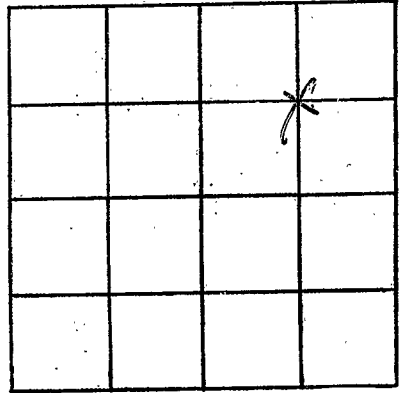

SECTION 23

Please indicate well location X.

ADDITIONAL INFORMATION

If more than one screen, show locations of each on sketch.