

CODED

MISSISSIPPI BOARD OF WATER COMMISSIONERS FEB 17 1972

416 North State Street
Jackson, Mississippi 39201

MISS. BD. OF
WATER COMMISSIONERS

WATER WELL DRILLERS LOG

PIKE
A123
1-18-71

18 Jan 1971 date well completed
S & P Water Well firm name
PIKE county well located

LANDOWNER:
Charles Freeman
Summit
(mailing address)

description of formations encountered	from	to
clay	0	25
chalk	25	45
sand	45	65
chalk sand	65	95
sand	95	140

WELL LOCATION:
sec. 8 T. 4 N. R. 3 E
4 miles N of Summit
(distance) (direction) (nearest town)

WELL PURPOSE:
(home, irrigation, municipal, industrial)

WELL COMPLETION DATA:

(1) diameter (inches) 4

(2) total depth (feet) 140

(3) static water level (feet) 80 below above top of ground.

(4) casing PI 134
(material) (depth)

_____ if telescope see back.
(size)

(5) screen 6 134
(length) (depth to top)

4 PI
(size) (material)

(6) pump 1/2 8
(HP) (yield gpm)

elect
(type power)

(7) electric log (yes or no) _____
(organization running log) _____


(8) how well bottom plugged used

CODED

DRILLERS REMARKS:

If well telescopes please sketch and show depths.

GROUND LEVEL

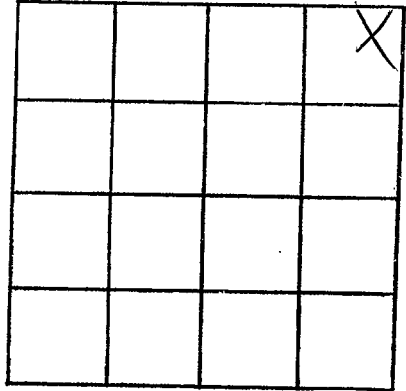

SECTION 8

Please indicate well location X.

ADDITIONAL INFORMATION

If more than one screen,
show locations of each on sketch.