

**PIKE**  
**ALSA**  
**12-30-71**

**CODED** MISSISSIPPI  
BOARD OF WATER COMMISSIONERS  
416 North State Street  
Jackson, Mississippi 39201

**WATER WELL DRILLERS LOG**


30 Dec 1971 S.P. Waterwell Pike  
date well completed firm name county well located

LANDOWNER:	description of formations encountered	from	to
<p><u>Eddie Ballans</u> <u>Summit</u> (mailing address)</p>	<p><u>clay</u> <u>clay sand</u> <u>clay</u> <u>hard</u></p>	<p><u>0</u> <u>25</u> <u>60</u> <u>70</u></p>	<p><u>25</u> <u>60</u> <u>70</u> <u>95</u></p>
<p>WELL LOCATION: sec <u>23</u> T <u>7</u> S R <u>1</u> E W <u>1</u> miles <u>N</u> of <u>Summit</u> (distance) (direction) (nearest town)</p>			
<p>WELL PURPOSE: (home, irrigation, municipal, industrial)</p>			
<p>WELL COMPLETION DATA:</p> <p>(1) diameter (inches) <u>4</u></p> <p>(2) total depth (feet) <u>25</u></p> <p>(3) static water level (feet) <u>65</u> below above top of ground.</p> <p>(4) casing <u>pl</u> <u>89</u> (material) (depth) (size) If telescope see back.</p> <p>(5) screen <u>6</u> <u>89</u> (length) (depth to top) <u>4</u> <u>pl</u> (size) (material)</p> <p>(6) pump <u>1/2</u> <u>3</u> (HP) (yield gpm) <u>210</u> (type power)</p> <p>(7) electric log <u>(yes or no)</u> (organization running log)</p> <p>(8) how well bottom plugged <u>wood</u></p>			
<p>DRILLERS REMARKS:</p>			

**CODED**

If well telescopes please sketch and show depths.

GROUND LEVEL

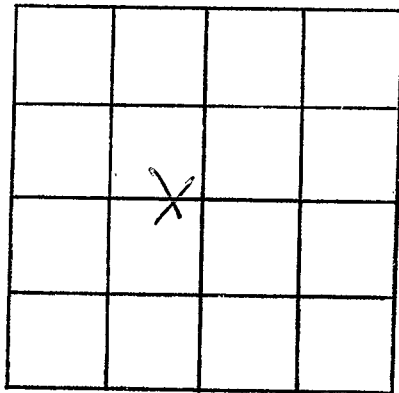

SECTION 23

Please indicate well location X.

ADDITIONAL INFORMATION

If more than one screen,  
show locations of each on sketch.