

Pike
A 125
2-18-72

MISSISSIPPI
 BOARD OF WATER COMMISSIONERS
 416 North State Street
 Jackson, Mississippi 39201

CODED

WATER WELL DRILLERS LOG

18 Feb. 1972 S&B Water Well Pike
 date well completed firm name county well located

LANDOWNER:
A. B. Cornuth
Summit
 (mailing address)

description of formations encountered	from	to
<u>clay</u>	<u>0</u>	<u>70</u>
<u>shale</u>	<u>70</u>	<u>85</u>
<u>chert</u>	<u>35</u>	<u>50</u>
<u>sand</u>	<u>50</u>	<u>87</u>

WELL LOCATION:
 sec. 11 T. 4 N. R. 7 E
5 miles N of Summit
 (distance) (direction) (nearest town)

WELL PURPOSE:
 (home, irrigation, municipal, industrial)

- WELL COMPLETION DATA:
- (1) diameter (inches) 4
 - (2) total depth (feet) 87 ft.
 - (3) static water level (feet) 30 below above top of ground.
 - (4) casing 81 81
 (material) (depth)
 (size) if telescope see back.
 - (5) screen 6 81
 (length) (depth to top)
4 81
 (size) (material)
 - (6) pump 1/2 2
 (HP) (yield gpm)
elect
 (type power)
 - (7) electric log (yes or no) _____
 (organization running log) _____
 - (8) how well bottom plugged wood

CODED


APR 7 1972

MISS. DEP. OF AGRICULTURE
 WASHINGTON, D.C.

DRILLERS REMARKS:

If well telescopes please sketch and show depths.

GROUND LEVEL

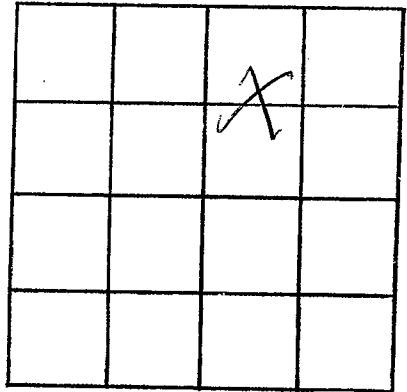

SECTION 11

Please indicate well location X.

ADDITIONAL INFORMATION

Lined area for additional information.

If more than one screen, show locations of each on sketch.