

Pike
A127
4-11-72

MISSISSIPPI
BOARD OF WATER COMMISSIONERS
416 North State Street
Jackson, Mississippi 39201

CODED

WATER WELL DRILLERS LOG

4-11-1972 date well completed
F. J. Small, Well Serv firm name
Pike county well located

LANDOWNER:	description of formations encountered	from	to
Billy Price			
R.R. Summit Drive (mailing address)	Red Clay Course Soil & gravel	6 20	20 112
WELL LOCATION: sec. 32 T 4 N R 7 E S W 1/2 miles W of Mendenhall (distance) (direction) (nearest town)			
WELL PURPOSE: Home (home, irrigation, municipal, industrial)			
WELL COMPLETION DATA:			
(1) diameter (inches) 4			
(2) total depth (feet) 112			
(3) static water level (feet) 60 below top of ground.			
(4) casing 104 (material) 104 (depth) 4 (size) if telescope see back.			
(5) screen 8 (length) 104 (depth to top) 4 (size) plastic (material)			
(6) pump 1 1/2 (HP) 10 (yield gpm) clear (type power)			
(7) electric log no (yes or no) (organization running log)			
(8) how well bottom plugged Wood peg			
DRILLERS REMARKS:			

CODED


APR 27 1972

MISS. BD. OF
WATER COM.

If well telescopes please sketch and show depths.

GROUND LEVEL

DEED

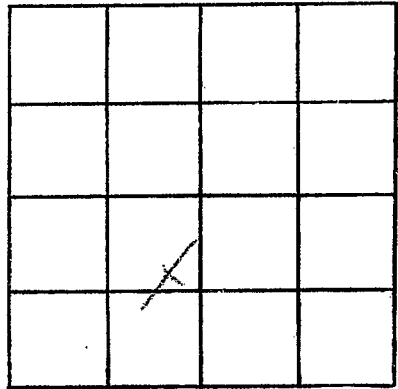

SECTION 32

Please indicate well location X.

ADDITIONAL INFORMATION

If more than one screen,
show locations of each on sketch.