

Pike
A128
2-9-72

MISSISSIPPI
BOARD OF WATER COMMISSIONERS
416 North State Street
Jackson, Mississippi 39201

CODED

WATER WELL DRILLERS LOG

Feb-9 1972 Chester Keener Pike
date well completed firm name county well located

LANDOWNER Robert D. Keener
RFD Summit

description of formations encountered	from	to
Red clay	0	12
Red Chalk	12	38
Red sand	38	75
Red Chalk	75	87
Chalk	87	103
Coarsesand - mudstone	103	113

(mailing address)

WELL LOCATION:

sec. 28 T. 4 N. R. 7 E
2 miles W of Summit
(distance) (direction) (nearest town)

WELL PURPOSE: Home
(home, irrigation, municipal, industrial)

WELL COMPLETION DATA:

- (1) diameter (inches) 4"
- (2) total depth (feet) 113
- (3) static water level (feet) 21 below top of ground.
- (4) casing Plast Bottom
(material) (depth)

(size) If telescope see back.

- (5) screen 6' 107
(length) (depth to top)
- 4" Plast
(size) (material)

- (6) pump 1/2 sub 12
(HP) (yield gpm)
- elect
(type power)

- (7) electric log NO
(yes or no)

(organization running log)

- (8) how well bottom plugged wooden plug

DRILLERS REMARKS:
New House.


CODED

REV 2 107
REV 3 107

MISS. WATER COMMISSION

If well telescopes please sketch and show depths.

GROUND LEVEL

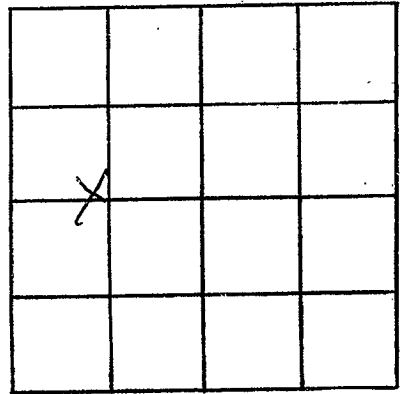

SECTION 29

Please indicate well location X.

ADDITIONAL INFORMATION

If more than one screen, show locations of each on sketch.