

MISSISSIPPI
 BOARD OF WATER COMMISSIONERS
 416 North State Street
 Jackson, Mississippi 39201

CODED

WATER WELL DRILLERS LOG

Pike
 A131
 5-22-72

May 22 1972 Chester Reeves Pike
 date well completed firm name county well located

LANDOWNER: Lamuel Adams
RFD Summit

description of formations encountered	from	to
Red clay	0	14
Red sand	14	60
Sand & gravel	60	68
Red chert	68	72
Sand & gravel	72	86

(mailing address)

WELL LOCATION:
 sec. 11 T. 4 N R. 7 E
2 miles N of Summit
 (distance) (direction) (nearest town)

WELL PURPOSE: Home
 (home, irrigation, municipal, industrial)

- WELL COMPLETION DATA:
- (1) diameter (inches) 4"
 - (2) total depth (feet) 86
 - (3) static water level (feet) 61 ^{below} _{above} top of ground.
 - (4) casing Plast bottom.
 (material) (depth)
 - (size) if telescope see back.
 - (5) screen 6' 80'
 (length) (depth to top)
 - 4" Plast
 (size) (material)
 - (6) pump 1/2 15
 (HP) (yield gpm)
 - Electric
 (type power)
 - (7) electric log NO
 (yes or no)

CODED

(organization running log)

(8) how well bottom plugged
wooden plug


DRILLERS REMARKS:
New location

JUN 20 1972

MISS. Bd. OF
 WATER COM.

If well telescopes please sketch and show depths.

GROUND LEVEL

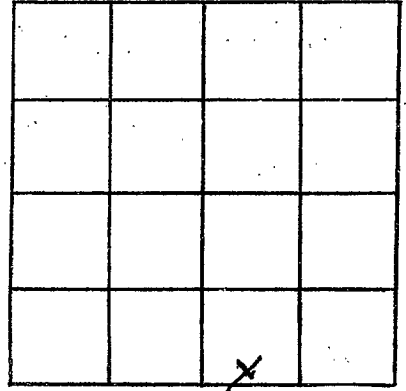

SECTION 11

Please indicate well location X.

ADDITIONAL INFORMATION

If more than one screen, show locations of each on sketch.