

Pike
A133
5-3-72

MISSISSIPPI
BOARD OF WATER COMMISSIONERS
416 North State Street
Jackson, Mississippi 39201

WATER WELL DRILLERS LOG

CODED

3 May 1972 S. P. Waterwell PIKE
date well completed firm name county well located

LANDOWNER:
David Thomas

WELL LOCATION:
sec. 2 T 4 N R 7 E
1 miles N of Dixie

WELL PURPOSE:
(home, irrigation, municipal, industrial)

- WELL COMPLETION DATA:
- (1) diameter (inches) 4
 - (2) total depth (feet) 125
 - (3) static water level (feet) 75 below top of ground.
 - (4) casing (material) PI (depth) 119
 - (size) if telescope see back.
 - (5) screen (length) 6 (depth to top) 119
 - (size) 4 (material) PI
 - (6) pump (HP) 1/2 (yield gpm) 8
 - (type power) Elect.
 - (7) electric log (yes or no)
 - (organization running log)
 - (8) how well bottom plugged Wood

description of formations encountered	from	to
Clay	0	20
Clay sh.	20	50
Chalk	50	70
Clay	70	70
Sand	70	125

CODED


MADE 25 1972

MISS. Bd. OF WATER COMMISSIONERS

DRILLERS REMARKS:

If well telescopes please sketch and show depths.

GROUND LEVEL

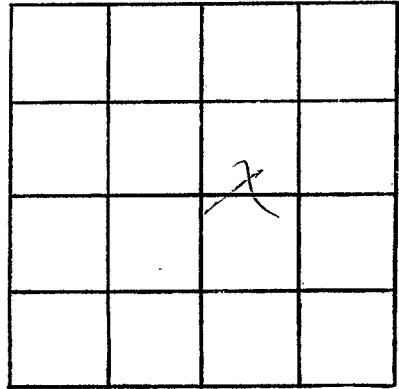

SECTION 2

Please indicate well location X.

ADDITIONAL INFORMATION

If more than one screen,
show locations of each on sketch.