

Pike
A 134
7-18-72

MISSISSIPPI
 BOARD OF WATER COMMISSIONERS
 416 North State Street
 Jackson, Mississippi 39201

CODED


WATER WELL DRILLERS LOG

7-18 1972 *Fitzgerald Well Serv* *Pete*
 date well completed firm name county well located

LANDOWNER:	description of formations encountered	from	to
<i>Callie Temple</i> <i>P.O. Summit Miss.</i> (mailing address)	<i>Red clay</i>	0	20
WELL LOCATION:	<i>Red sand</i>	20	75
sec. <u>33</u> T <u>4</u> N R <u>7</u> E <u>2</u> miles <u>W</u> of <u>McComb</u> (distance) (direction) (nearest town)	<i>Red sand</i>	70	110
WELL PURPOSE: (home, irrigation, municipal, industrial)	<i>Coarse sand & gravel</i>	110	122
WELL COMPLETION DATA:	CODED		
(1) diameter (inches) <u>4</u>			
(2) total depth (feet) <u>122</u>			
(3) static water level (feet) <u>75</u> below top of ground.			
(4) casing <u>plastic</u> , <u>114</u> (material) (depth)			
<u>4</u> if telescope see back. (size)			
(5) screen <u>8</u> , <u>114</u> (length) (depth to top)			
(6) pump <u>4</u> , <u>plastic</u> (size) (material)			
(7) electric log <u>no</u> (yes or no)			
(8) how well bottom plugged <u>wood plug</u>			
DRILLERS REMARKS:	AUG 7 1972		
	MISS. BD. OF WATER COMMISSIONERS		

If well telescopes please sketch and show depths.

GROUND LEVEL

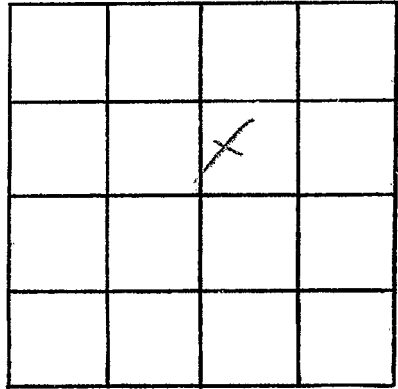

SECTION 33

Please indicate well location X.

ADDITIONAL INFORMATION

If more than one screen,
show locations of each on sketch.