

Pike
 A135
 8-28-72

MISSISSIPPI
 BOARD OF WATER COMMISSIONERS
 416 North State Street
 Jackson, Mississippi 39201

CODED

WATER WELL DRILLERS LOG

28 August 1972 J. J. Thompson RPK
 date well completed firm name county well located

LANDOWNER: description of formations encountered from to
 McComb Humphreys
 McComb
 (mailing address) clay 0 25
 shaly 25 50
 sand chert 30 60
 sand 60 87

WELL LOCATION:
 sec. 35 T 4 N R 7 E
 2 miles S of Summit
 (distance) (direction) (nearest town)

WELL PURPOSE:
 (home, irrigation, municipal, industrial)

WELL COMPLETION DATA:
 (1) diameter (inches) 4
 (2) total depth (feet) 87
 (3) static water level (feet) 60 below above top of ground.
 (4) casing 81 - 81 (material) (depth)
 (size) if telescope see back.
 (5) screen 6' 51" (length) (depth to top)
 (size) (material)
 (6) pump 1/2 3 (HP) (yield gpm)
 (type power)
 (7) electric log (yes or no)
 (organization running log)
 (8) how well bottom plugged wood

CODED


SEP 1 1972

MISS. DEPT. OF WATER CONTROL

DRILLERS REMARKS:

If well telescopes please sketch and show depths.

GROUND LEVEL

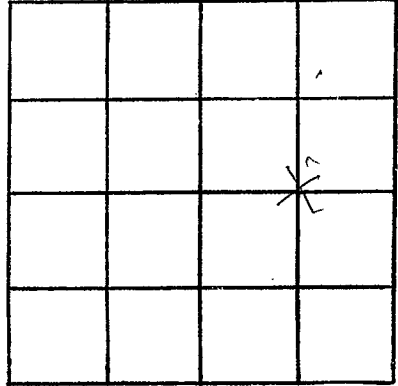

SECTION 25

Please indicate well location X.

ADDITIONAL INFORMATION

If more than one screen, show locations of each on sketch.