

Pike
 A136
 7-22-72

MISSISSIPPI
 BOARD OF WATER COMMISSIONERS
 416 North State Street
 Jackson, Mississippi 39201

WATER WELL DRILLERS LOG **CODED**

225 al 72 *S&P Water Well*
 date well completed firm name county well located

LANDOWNER:
W.H. Diez

Summit
 (mailing address)

WELL LOCATION:
 sec. *10* T *4* N R *7* E
4 miles *N* of *Summit*
 (distance) (direction) (nearest town)

description of formations encountered	from	to
<i>Clay</i>	<i>0</i>	<i>15</i>
<i>Chalk</i>	<i>15</i>	<i>25</i>
<i>Sand chert</i>	<i>35</i>	<i>50</i>
<i>Chalk</i>	<i>50</i>	<i>75</i>
<i>Sand</i>	<i>75</i>	<i>110</i>

WELL PURPOSE:
 (home, irrigation, municipal, industrial)

WELL COMPLETION DATA:

(1) diameter (inches) *4*

(2) total depth (feet) *110*

(3) static water level (feet) *75* below top of ground.

(4) casing *PI* *104*
 (material) (depth)
 (size) If telescope see back.

(5) screen *4* *104*
 (length) (depth to top)
4 *PI*
 (size) (material)

(6) pump *1/2* *8*
 (HP) (yield gpm)
Electric
 (type power)

(7) electric log _____
 (yes or no)

 (organization running log)

(8) how well bottom plugged *used*

CODED


SEP 1 1972

MISC

DRILLERS REMARKS:

If well telescopes please sketch and show depths.

GROUND LEVEL

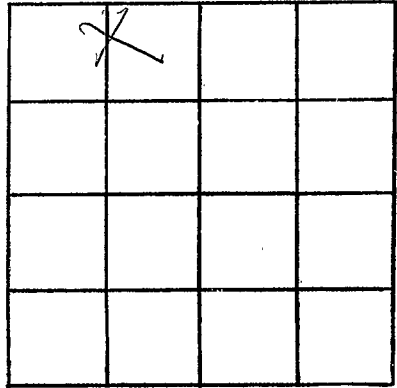

SECTION 6

Please indicate well location X.

ADDITIONAL INFORMATION

If more than one screen, show locations of each on sketch.