

Pike
 A137
 7-26-72

MISSISSIPPI
 BOARD OF WATER COMMISSIONERS
 416 North State Street
 Jackson, Mississippi 39201

CODED

WATER WELL DRILLERS LOG

26 Aug 1972 data well completed
 SFF Water Well PIKE firm name
 county well located

LANDOWNER:
 Darrell Stewart
 Summit
 (mailing address)

WELL LOCATION:
 sec 28 T 4 N R 17 E
 3 miles W of Summit
 (distance) (direction) (nearest town)

WELL PURPOSE:
 (home, irrigation, municipal, industrial)

- WELL COMPLETION DATA:
- (1) diameter (inches) 4
 - (2) total depth (feet) 122
 - (3) static water level (feet) 80 below above top of ground
 - (4) casing PI 122
 (material) (depth)
4 if telescope see back.
 (size)
 - (5) screen 6 122
 (length) (depth to top)
4 PI
 (size) (material)
 - (6) pump 4 8
 (HP) (yield gpm)
quilt
 (type power)
 - (7) electric log _____
 (yes or no)

 (organization running log)
 - (8) how well bottom plugged good

description of formations encountered	from	to
Clay	0	25
Chalky clay	25	40
Sandstone	40	60
Chalk	60	70
Iron	70	122


CODED

SEP 1 1972

DRILLERS REMARKS:

If well telescopes please sketch and show depths.

GROUND LEVEL

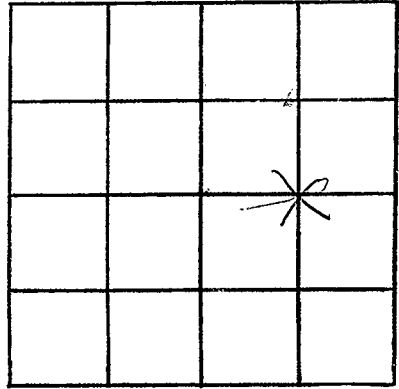

SECTION 28

Please indicate well location X.

ADDITIONAL INFORMATION

If more than one screen,
show locations of each on sketch.