

Pike  
A 138  
7-27-72

MISSISSIPPI  
 BOARD OF WATER COMMISSIONERS  
 416 North State Street  
 Jackson, Mississippi 39201

**CODED**

WATER WELL DRILLERS LOG

July 27 19 72 Fitzgerald Well Dr Pike  
 date well completed firm name county well located


| LANDOWNER:   | description of formations encountered | from       | to         |
|--|---------------------------------------|------------|------------|
| <u>F. B. Thornton</u>  |                                       |            |            |
| <u>R. R. Littlefield</u><br>(mailing address)                                      | <u>Red sand</u>                       | <u>20</u>  | <u>60</u>  |
|  | <u>White + Blue clay</u>              | <u>60</u>  | <u>140</u> |
|  | <u>Fire log</u>                       | <u>140</u> | <u>145</u> |
|  | <u>same sand</u>                      | <u>145</u> | <u>158</u> |
| WELL LOCATION:<br>sec. <u>19</u> T. <u>4</u> S. R. <u>17</u> E. W. <u>5</u>        |                                       |            |            |
| <u>5</u> miles <u>W</u> of <u>Summitt</u><br>(distance) (direction) (nearest town) |                                       |            |            |
| WELL PURPOSE: <u>Home</u><br>(home, irrigation, municipal, industrial)             |                                       |            |            |
| WELL COMPLETION DATA:  |                                       |            |            |
| (1) diameter (inches) <u>4</u>   |                                       |            |            |
| (2) total depth (feet) <u>158</u>  |                                       |            |            |
| (3) static water level (feet) <u>75</u> below above top of ground.                 |                                       |            |            |
| (4) casing <u>plaster</u> , <u>150</u> ,<br>(material) (depth)                     |                                       |            |            |
| <u>4</u><br>(size) if telescope see back.  |                                       |            |            |
| (5) screen <u>8</u> , <u>150</u><br>(length) (depth to top)                        |                                       |            |            |
| <u>4</u> , <u>plaster</u><br>(size) (material)                                     |                                       |            |            |
| (6) pump <u>3/4</u> , <u>15</u><br>(HP) (yield gpm)                                |                                       |            |            |
| <u>elec</u><br>(type power)  |                                       |            |            |
| (7) electric log <u>no</u><br>(yes or no)  |                                       |            |            |
| (organization running log)   |                                       |            |            |
| (8) how well bottom plugged <u>wood peg</u>  |                                       |            |            |
| DRILLERS REMARKS:  |                                       |            |            |

**CODED**

7 1972  
 SET

If well telescopes please sketch and show depths.

GROUND LEVEL

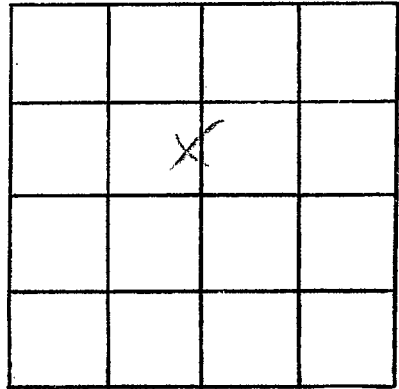

SECTION 19

Please indicate well location X.

ADDITIONAL INFORMATION

Lined area for additional information.

If more than one screen, show locations of each on sketch.