

MISSISSIPPI
BOARD OF WATER COMMISSIONERS
416 North State Street
Jackson, Mississippi 39201

WATER WELL DRILLERS LOG

Pike
A 139
8-9-72

Aug 9 1972 date well completed
Chester Reeves firm name
Pike county well located

LANDOWNER: Charles
Bolan
RFD Summit -
(mailing address)

WELL LOCATION:
sec. 3 T. 4 N. R. 7 E
4 miles NW of Summit
(distance) (direction) (nearest town)

WELL PURPOSE: Home
(home, irrigation, municipal, industrial)

WELL COMPLETION DATA:
(1) diameter (inches): 4"
(2) total depth (feet): 104
(3) static water level (feet): 173 below top of ground
(4) casing: Plast below
(material) (depth)
(size) If telescope see back.
(5) screen: 6' 98'
(length) (depth to top)
4" Plast
(size) (material)
(6) pump: Owner's Pump
(HP) (yield gpm)
ELECT
(type power)
(7) electric log: No
(yes or no)
(organization running log)

description of formations encountered	from	to
clay	0	17
Red sand	17	38
Sand & gravel	38	55
chalk gravel & cob-balls	55	92
small gravel	92	104


(8) how well bottom plugged:
wood plug
DRILLERS REMARKS:
New location

DEC 1 1972

FORM NO. 1017-1-72
ISSUED BY
MARCH 1972

If well telescopes please sketch and show depths.

GROUND LEVEL

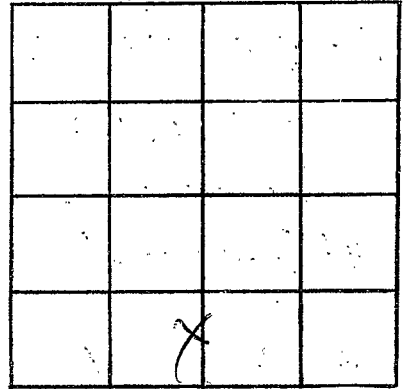

SECTION B

Please indicate well location X.

ADDITIONAL INFORMATION

If more than one screen, show locations of each on sketch.